3100

IREDELL COUNTY HEALTH DEPARTMENT

STATESVILLE 704-878-5305 MOORESVILLE 704-664-5281

IMPROVEMENT PERMIT / AUTHORIZATION TO CONSTRUCT / OPERATION PERMIT / EXISTING SYSTEM INSPECTION

PERMIT# 142128 PIN# 4625775672 DATE 5-4-07

OWNER OR APPLICANT Kenneth Beaver Homes PHONE: Business 662-6400 Home

ADDRESS P.O. Box 3398 Mooresville, NC. 28117

LOCATION Brawley School Rd TR Marstons Mill TL White Horse TL Balston TR Brownstone attend

SUBDIVISION Point BLOCK / SECTION 4 LOT 442 LOT AREA 47977 SITE CLASS. PS DESIGN FLOW 600gpd L.T.A.R. .25

Septic Tank 1000 Gallons: STB 338 Date 5-12-07 ☒ New System ☐ Repair ☐ Expansion System Type: I II III IV V VI ☒ House/Mod. Home No. Bedrooms 4 ☐ Water Supply: ☐ Individual

Pump Tank 1500/1000 Gallons: PT 444 Date 7-2-07 System Description: Pump - 25% Reduction ☐ Mobile Home No. Persons 2 ☒ Public

Pump Make Goulds Model WE1012HC Serial No. Repair System Description: Same ☐ Business No. Employees ☒ Community

Nitrification Field 600/600 Square Feet 1440 Linear Feet 600 Maintenance Agreement Required: ☐ Yes ☒ No Offsite ☐ Other

No Lines 6@100 Trench Width 36" Max Trench Bottom Depth 36" Gravel Depth N/A ☐ Gravity ☒ Pressure ☐ Slab ☐ Crawl Space ☒ Basement w/plumbing ☐ Basement wo/plumbing

Comments:/Conditions Remove all terraces & berms

5 lines @ 96 ft ea or 6 lines @ 80 ft.


6/24/08 Installed 600/100ft = 600ft EZ Flow Set Pressure

Comments:/Conditions: 7/3/07 Reviewed Building plans, essentially in compliance with I.P.


10/9/07 Checked tanks

Scale 1:50

INITIAL SITE SKETCH Scale 1:100'

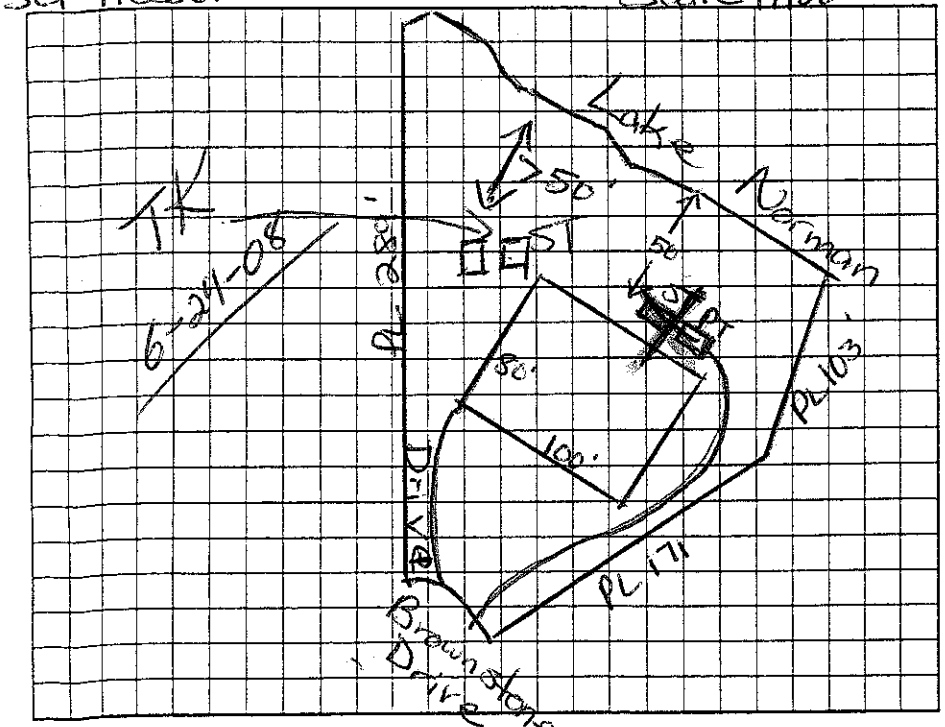

AS BUILT SKETCH

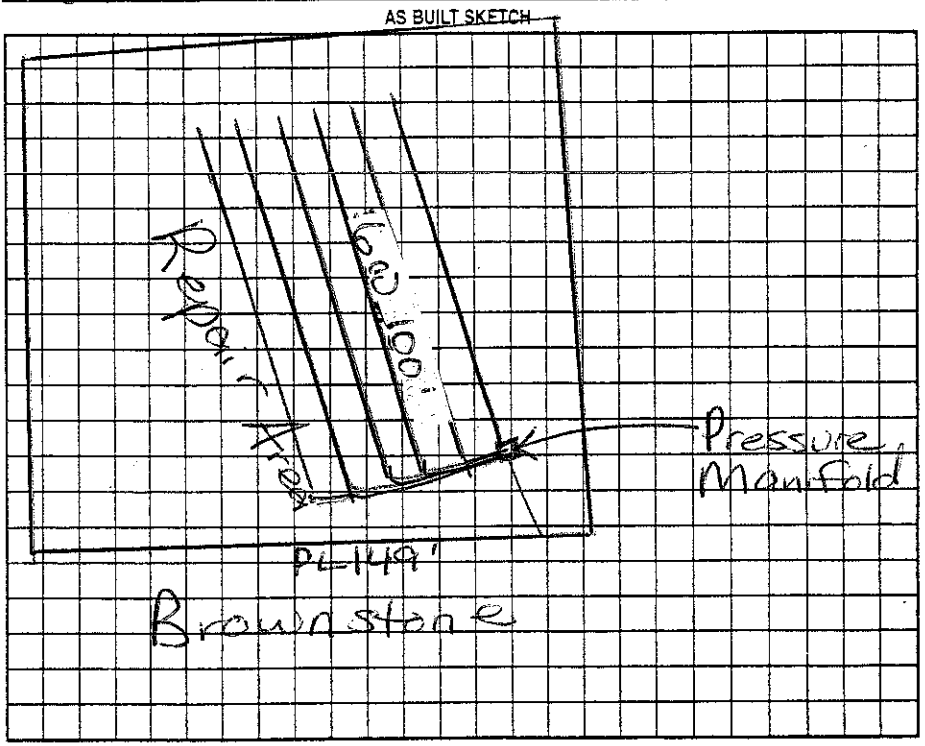

Permit can be suspended or revoked if any false information is supplied toward securing the permit/any unauthorized changes are made to the site/any unauthorized changes are made in the installation of the system. Improvement Permit with plat valid without expiration ☐ Improvement Permit with site plan valid for sixty months ☐ Authorization to Construct is valid for a period equal to that of Improvement Permit – not to exceed sixty months.

Signed:

Improvement Permit by: Marvin H. Nelson RS date 5/17/07

Authorization to Construct by: Marvin H. Nelson RS date 5/4/07

Installed by: Kevin Hallman date 7/3/07

Operation Permit by: Wesley Sparks R.S. date 8/11/08

Existing System Inspection by: date

HEALTH DEPT. COPY: WHITE OWNER COPY (FINAL): YELLOW OWNER COPY (INITIAL): PINK