4625777701

IREDELL COUNTY HEALTH DEPARTMENT

STATESVILLE 704-878-5305 MOORESVILLE 704-664-5281

IMPROVEMENT PERMIT / AUTHORIZATION TO CONSTRUCT / OPERATION PERMIT / EXISTING SYSTEM INSPECTION

PERMIT# 82398 PIN# 4625941684 Pt. DATE 4/22/2002

OWNER OR CONTRACTOR Brookshire Construction PHONE: Business Home

ADDRESS

LOCATION Brawley School Rd TR Marstons Mill TL White House TL Ballson TR Brownstone at end

SUBDIVISION Point BLOCK / SECTION 4 LOT 441 LOT AREA 47986 SITE CLASS. PS DESIGN FLOW 480 L.T.A.R. .2

Septic Tank: 1500 Gallons; STB 338 Date 9-22-01

Pump Tank: 1000 Gallons; PT 283 Date 10-14-01

Pump Make: Model Serial No.

Nitrification Field: No Fields 1 Square Feet 1800 Linear Feet 600

No Lines 7 Trench Width 36" Max Trench Bottom Depth 18" Gravel Depth N/A

☒ New System ☐ Repair System Type: I, II, III, IV, V, VI

System Description: Pump EZ Flow

Repair System Description: Lp Panel

Maintenance Agreement Required: ☐ Yes ☒ No

☒ House/Mod. Home No. Bedrooms 4

☐ Mobile Home No. Bathrooms 4

☐ Business No. Employees

☐ Other


☐ Slab ☒ Crawl Space ☒ Basement w/plumbing ☐ Basement wo/plumbing

Water Supply: ☐ Individual ☒ Public ☒ Community

Comments/Conditions:


Lake Norman

INITIAL SITE SKETCH

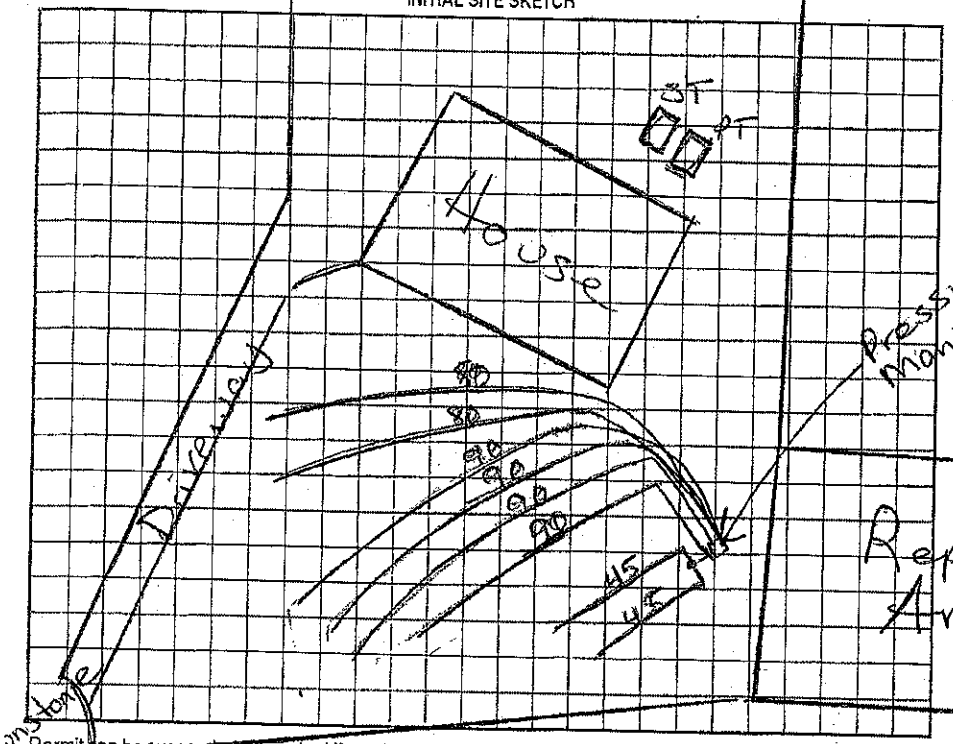

Comments/Conditions:

AS BUILT SKETCH

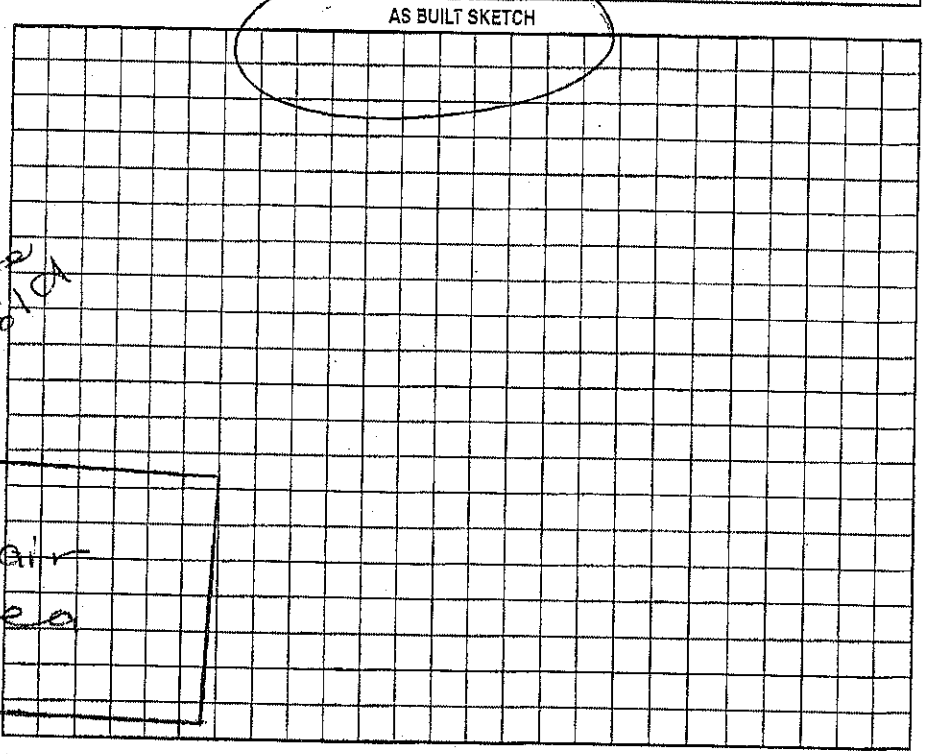

Permit can be suspended or revoked if any false information is supplied toward securing the permit/any unauthorized changes are made to the site/any unauthorized changes are made in the installation of the system. Improvement Permit with plat valid without expiration. Improvement Permit with site plan valid for sixty months. Authorization to Construct is valid for a period equal to that of Improvement Permit – not to exceed sixty months.

Signed: date

Improvement Permit by: date

Authorization to Construct by: date

Installed by: R & H Inc

Operation Permit by: Maria Dotson RS date 4/22/2002

Existing System Inspection by: date

HEALTH DEPT. COPY: WHITE OWNER COPY (FINAL): YELLOW OWNER COPY (INITIAL): PINK