IREDELL COUNTY HEALTH DEPARTMENT

STATESVILLE 704-878-5305 MOORESVILLE 704-664-5281

IMPROVEMENT PERMIT / AUTHORIZATION TO CONSTRUCT / OPERATION PERMIT / EXISTING SYSTEM INSPECTIO

PERMIT# 8240 3 PIN# ~~4625944684 PT~~ 4625-77-8037 DATE ~~1~~ 1-21-2002

OWNER OR CONTRACTOR CRI — Hughes, Hamelink & Zande PHONE: Business (704) 375-5999 Home

ADDRESS 909 East Blvd Charlotte NC 28036

LOCATION Brawley School Rd TR Marstons TL White Horse TL Balliston TR Brownstone on left

SUBDIVISION The Point BLOCK / SECTION 4 LOT 447 LOT AREA 60,497sqft SITE CLASS. PS DESIGN FLOW 600gpd L.T.A.R. .3

Septic Tank: 1500 Gallons; STB 338 Date 10-15-00 ☒ New System ☐ Repair System Type: I, II, III, IV, V, VI

Pump Tank: 1500 Gallons; PT 338 Date 12-31-01 System Description: Pump-LP-Panel Block

Pump Make: Myers Model ME505-21 Serial No. 11-01 Repair System Description: Same

Nitrification Field: No Fields 1 Square Feet 1050 Linear Feet 350' Maintenance Agreement Required: ☒ Yes ☐ No

No Lines 5 @ 70' Trench Width 36" Max Trench Bottom Depth 36" Gravel Depth N/A

☒ House/Mod. Home ☐ Mobile Home ☐ Business ☐ Other

No. Bedrooms 5 No. Bathrooms 4.5 No. Employees


☐ Slab ☐ Crawl Space ☑ Basement w/plumbing ☐ Basement wo/plumbing

Water Supply: ☐ Individual ☒ Public ☒ Community


Comments:/Conditions:

Comments:/Conditions: Lines checked 1/31/2002
Tanks checked 2/2002
Pres. Elect & alarm checked 5/30/02

INITIAL SITE SKETCH Scale 1:50'

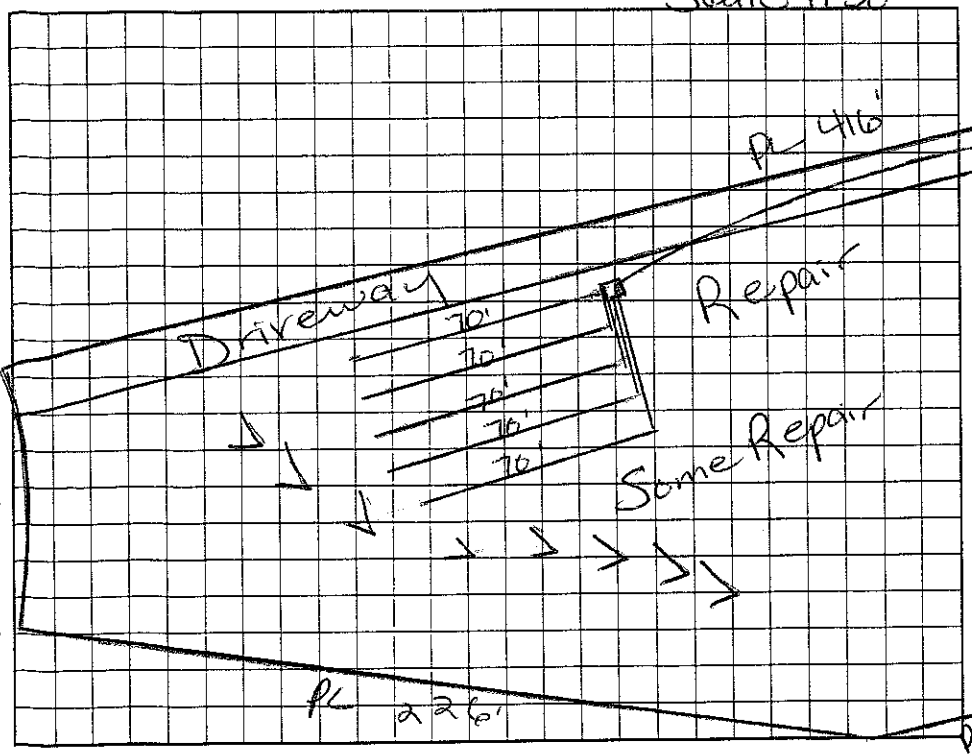

AS BUILT SKETCH

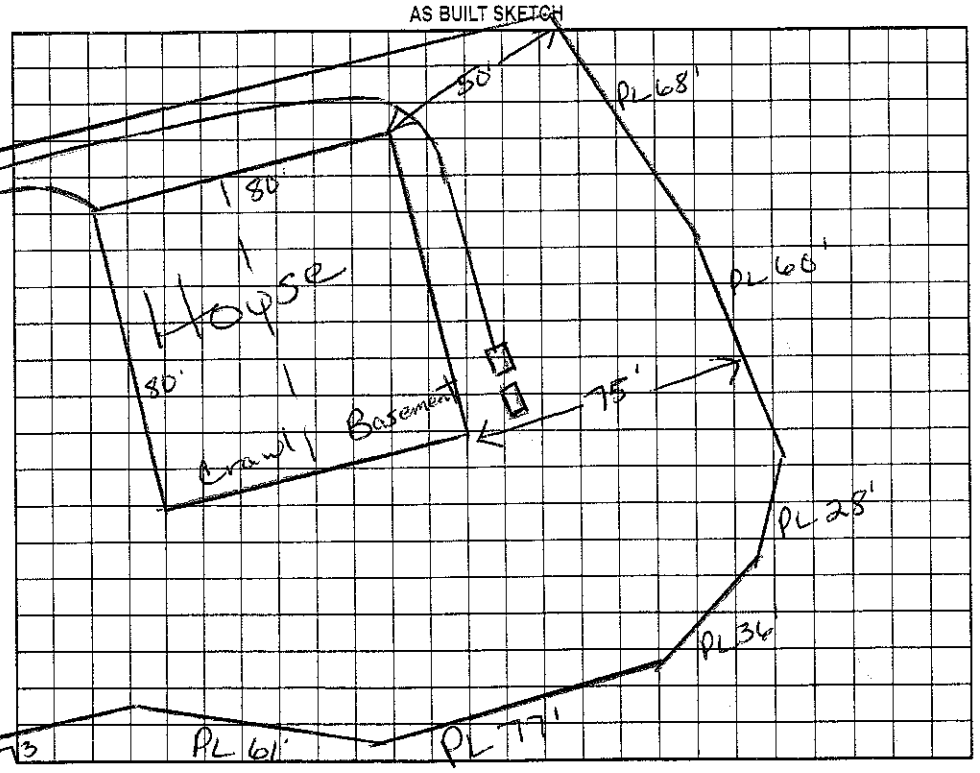

Permit can be suspended or revoked if any false information is supplied toward securing the permit/any unauthorized changes are made to the site/any unauthorized changes are made in the installation of the system. Improvement Permit with plat valid without expiration. Improvement Permit with site plan valid for sixty months. Authorization to Construct is valid for a period equal to that of Improvement Permit – not to exceed sixty months.

Signed: Charles B. Hughes Jr. for H.H.Z. date

Improvement Permit by: Maria H. Hall Dotson RS date 1/31/2002

Authorization to Construct by: Maria H. Hall Dotson RS date 2/21/2002

Installed by: Bobby Mayberry RS

Operation Permit by: Maria H. Hall Dotson date 5/30/02

Existing System Inspection by: date

HEALTH DEPT. COPY: WHITE OWNER COPY (FINAL): YELLOW OWNER COPY (INITIAL): PINK