As Built Drawing

IREDELL COUNTY HEALTH DEPARTMENT

STATESVILLE 704-878-5305 MOORESVILLE 704-664-5281

IMPROVEMENT PERMIT / AUTHORIZATION TO CONSTRUCT / OPERATION PERMIT / EXISTING SYSTEM INSPECTION

PERMIT# 82362 PIN# 4625941684 Pt DATE 6/11/03

OWNER OR CONTRACTOR Dienst Custom Homes PHONE: Business 892-8426 Home

ADDRESS

LOCATION

SUBDIVISION The Point BLOCK / SECTION 4 LOT 4410 LOT AREA 35,610 SITE CLASS. PS DESIGN FLOW 480gpd L.T.A.R. .3

Septic Tank: Gallons; STB Date
Pump Tank: Gallons; PT Date
Pump Make: Model Serial No.
Nitrification Field: No Fields 1 Square Feet 900 Linear Feet 300
No Lines 3@100 Trench Width 36" Max Trench Bottom Depth 36" Gravel Depth N/A

☐ New System ☐ Repair System Type: I, II, III, IV, V, VI
System Description: LP-Panel Pump
Repair System Description: Same
Maintenance Agreement Required: ☐ Yes ☐ No

☐ House/Mod. Home No. Bedrooms
☐ Mobile Home No. Bathrooms
☐ Business No. Employees
☐ Other


☐ Slab ☒ Crawl Space ☐ Basement w/plumbing ☐ Basement wo/plumbing

Water Supply: ☐ Individual ☐ Public ☐ Community


Comments:/Conditions:

Comments:/Conditions: Note: 1st Drain line ~ 25' From pool deck.

Scale 1:40 INITIAL SITE SKETCH

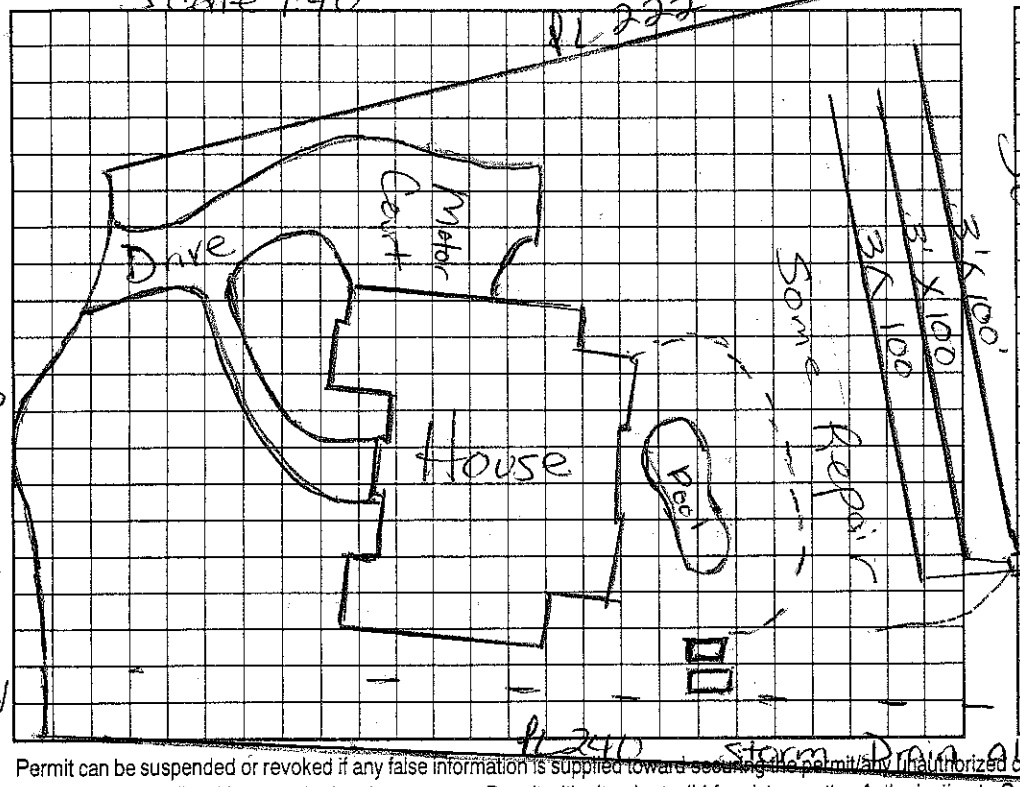

AS BUILT SKETCH

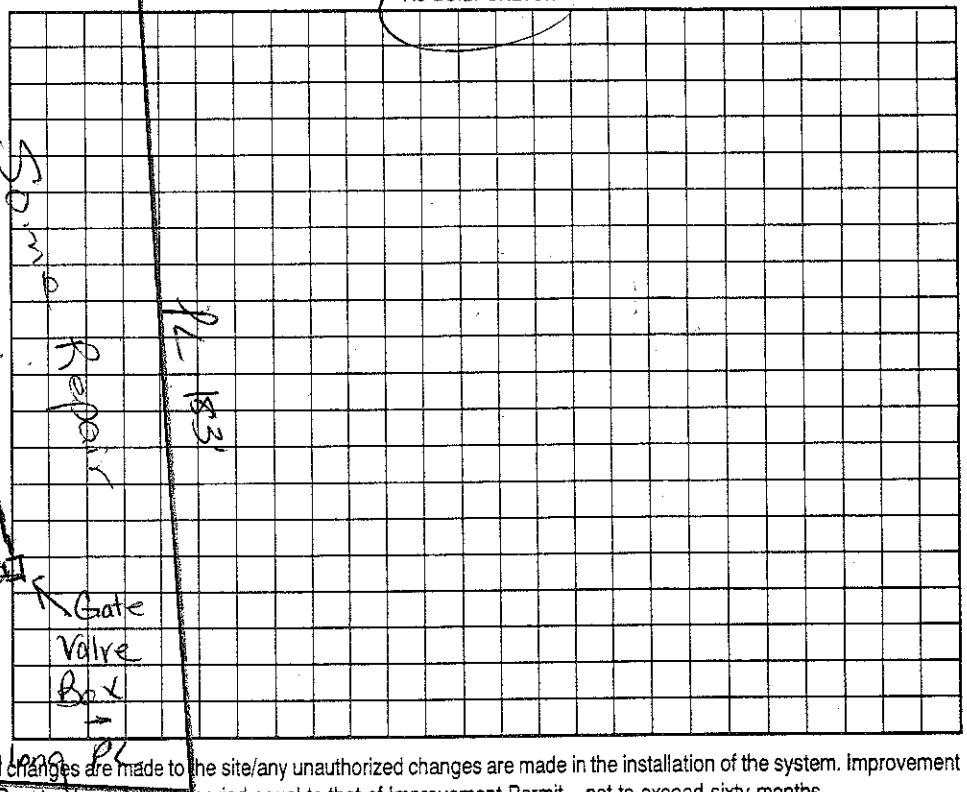

Permit can be suspended or revoked if any false information is supplied toward securing the permit/any unauthorized changes are made to the site/any unauthorized changes are made in the installation of the system. Improvement Permit with plat valid without expiration. Improvement Permit with site plan valid for sixty months. Authorization to Construct is valid for a period equal to that of Improvement Permit – not to exceed sixty months.

Signed: date

Improvement Permit by: date

Authorization to Construct by: Maria H. Eaton date 6/11/03

Installed by: R & H Inc

Operation Permit by: Maria H. Eaton date 6/11/03

Existing System Inspection by: date

HEALTH DEPT. COPY: WHITE OWNER COPY (FINAL): YELLOW OWNER COPY (INITIAL): PINK