IREDELL COUNTY HEALTH DEPARTMENT

STATESVILLE 704-878-5305 50.00 Paid MOORESVILLE 704-664-5281

IMPROVEMENT PERMIT / AUTHORIZATION TO CONSTRUCT / OPERATION PERMIT / EXISTING SYSTEM INSPECTION

PERMIT# 82362 PIN# ~~4625941684 PT~~ 4625-77-8670 DATE 10/9/2002

OWNER OR CONTRACTOR Dienst Custom Homes PHONE: Business 892-8426 Home

ADDRESS 9606A Caldwell Commons Cornelius, NC 28031

LOCATION Brawley School Rd TR, Marstons Mill TL White Horse TL Ballstone TR Brownstone at end

SUBDIVISION The Point BLOCK / SECTION 4 LOT 440 LOT AREA 35,610 SITE CLASS. PS DESIGN FLOW ~~450~~ 450 gpd L.T.A.R. .3

Septic Tank: ~~1000~~ 1500 Gallons; STB 338 Date 3-28-03

Pump Tank: ~~1000~~ 1000 Gallons; PT 27 Date 4-1-03

Pump Make: Model Serial No.

Nitrification Field: No Fields 1 Square Feet 900' Linear Feet 300'

No Lines 3@100' Trench Width 36" Max Trench Bottom Depth 36" Gravel Depth N/A

☒ New System ☐ Repair System Type: I. II. III. IV. V. VI

System Description: LP Panel

Repair System Description: Same

Maintenance Agreement Required: ☒ Yes ☐ No

☒ House/Mod. Home No. Bedrooms 4

☐ Mobile Home No. Bathrooms 4

☐ Business No. Employees

☐ Other

☐ Slab ☒ Crawl Space ☐ Basement w/plumbing ☐ Basement wo/plumbing


Water Supply: ☐ Individual ☒ Public ☒ Community

Comments/Conditions: Keep Septic System at least 10' From PL & 15' From Pool


Comments/Conditions: Tanks checked 5/12/03 mb
Lines checked 6/10/03

Scale 1:40

INITIAL SITE SKETCH

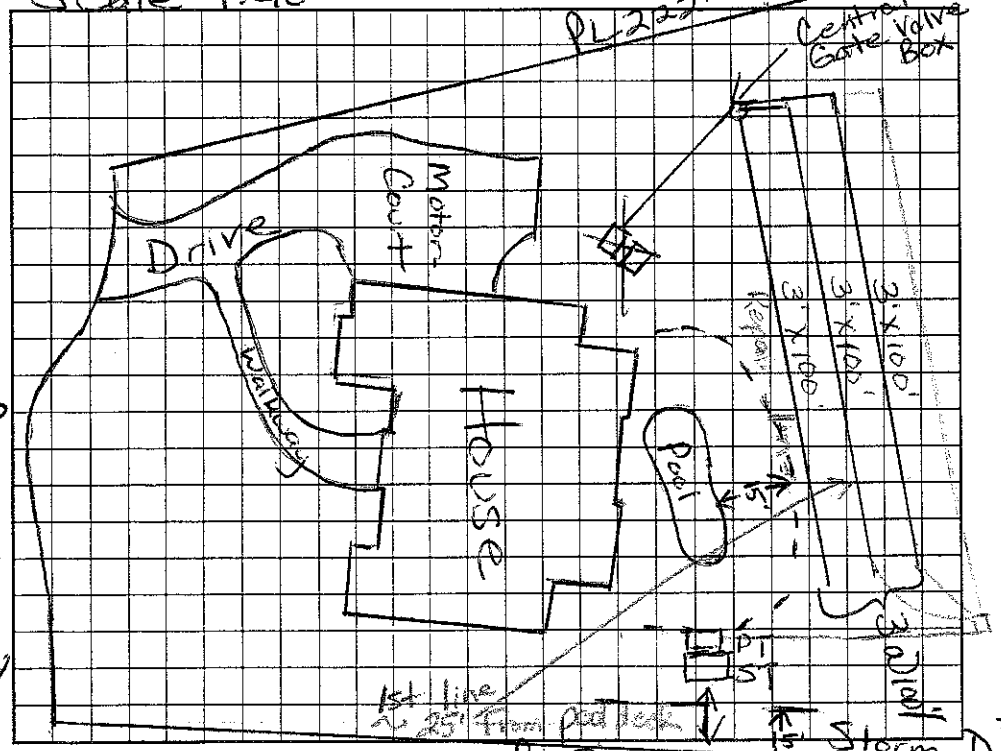

AS BUILT SKETCH

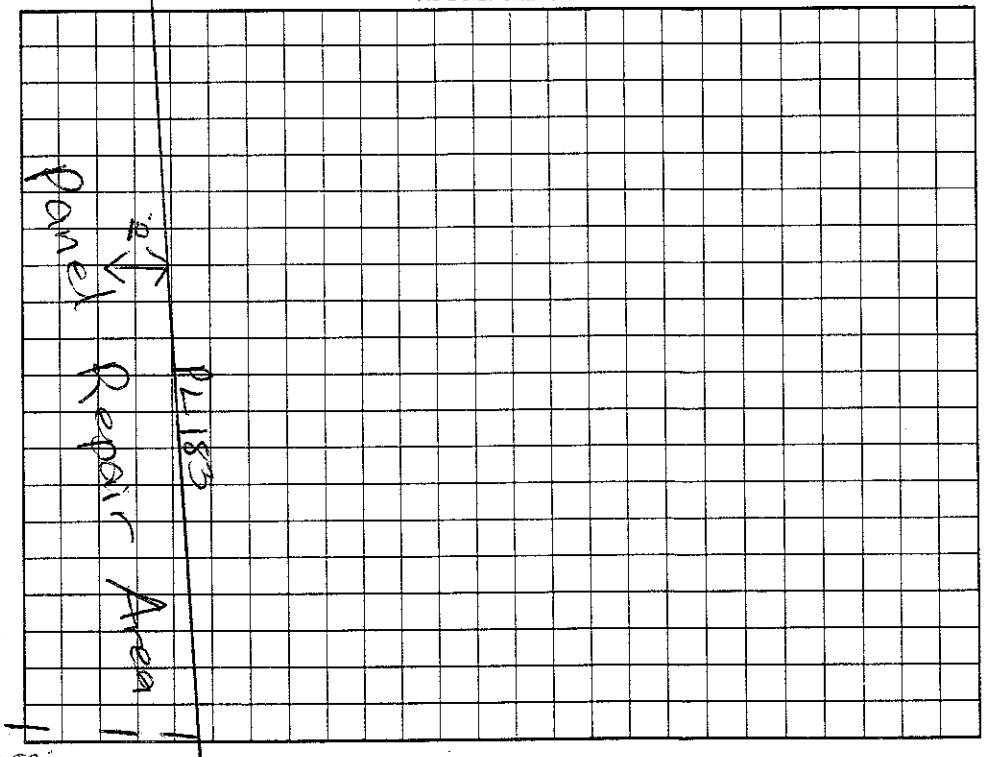

Permit can be suspended or revoked if any false information is supplied toward securing the permit/any unauthorized changes are made to the site/any unauthorized changes are made in the installation of the system. Improvement Permit with plat valid without expiration. Improvement Permit with site plan valid for sixty months. Authorization to Construct is valid for a period equal to that of Improvement Permit – not to exceed sixty months.

Signed: [signature] RS date 10/11/02

Improvement Permit by: [signature] RS date 10/10/02

Authorization to Construct by: [signature] RS date 10/10/02

Installed by: R & H Inc

Operation Permit by: [signature] RS date 6/11/03

Existing System Inspection by: date

HEALTH DEPT. COPY: WHITE OWNER COPY (FINAL): YELLOW OWNER COPY (INITIAL): PINK