132995

DUNTY HEALTH DEPARTMENT
ENT PERMIT / AUTHORIZATION TO CONSTRUCT / OPERATION PERMIT / EXISTING SYSTEM INSPECTION

STATESVILLE 704-878-5305 — MOORESVILLE 704-664-5281

210 132994 [redacted] 4625-78-2481

R CRESCENT RESOURCES / DIENST — PHONE: Business 6636905 JACOBS Home

1003 CHARLOTTE NC 28202

LY SCHOOL - TR MARSONS MILL - TL WHITE HORSE ON RT — DATE 1/12/00

BLOCK / SECTION 4 LOT 414 LOT AREA 105,263 SITE CLASS. PS DESIGN FLOW 600 GPD L.T.A.R. 3 gal/sq ft

Septic Tank: 1500 Gallons; STB 444 Date 3-1-00

Pump Tank: 1500 Gallons; PT 477 Date 4-11-00

Pump Make: Myers Model ME50 Serial No.

Nitrification Field: No Fields 1 Square Feet 1500 Linear Feet 500

No Lines 5@100' Trench Width 36" Max Trench Bottom Depth 36"

Gravel Depth N/A

☑ New System ☐ Repair System Type: I, II, III, IV, V, VI

System Description: PUMP 25% REDUCTION

Repair System Description: SAME

Maintenance Agreement Required: ☐ Yes ☑ No OFFSITE

☐ Slab ☐ Crawl Space ☑ Basement w/plumbing ☐ Basement wo/plumbing

☑ House/Mod. Home ☐ Mobile Home ☐ Business ☐ Other

No. Bedrooms 5 No. Bathrooms 5 No. Employees


Water Supply: ☐ Individual ☐ Public ☑ Community

Comments/Conditions: REMOVE ALL TERRACES AND BERMS

Comments/Conditions: EZ Flow installed
Checked lines 4/2/03
Checked tanks 7/12/06 MD
Pressure check & alarm 9/15/06 MD


1"=100'

INITIAL SITE SKETCH

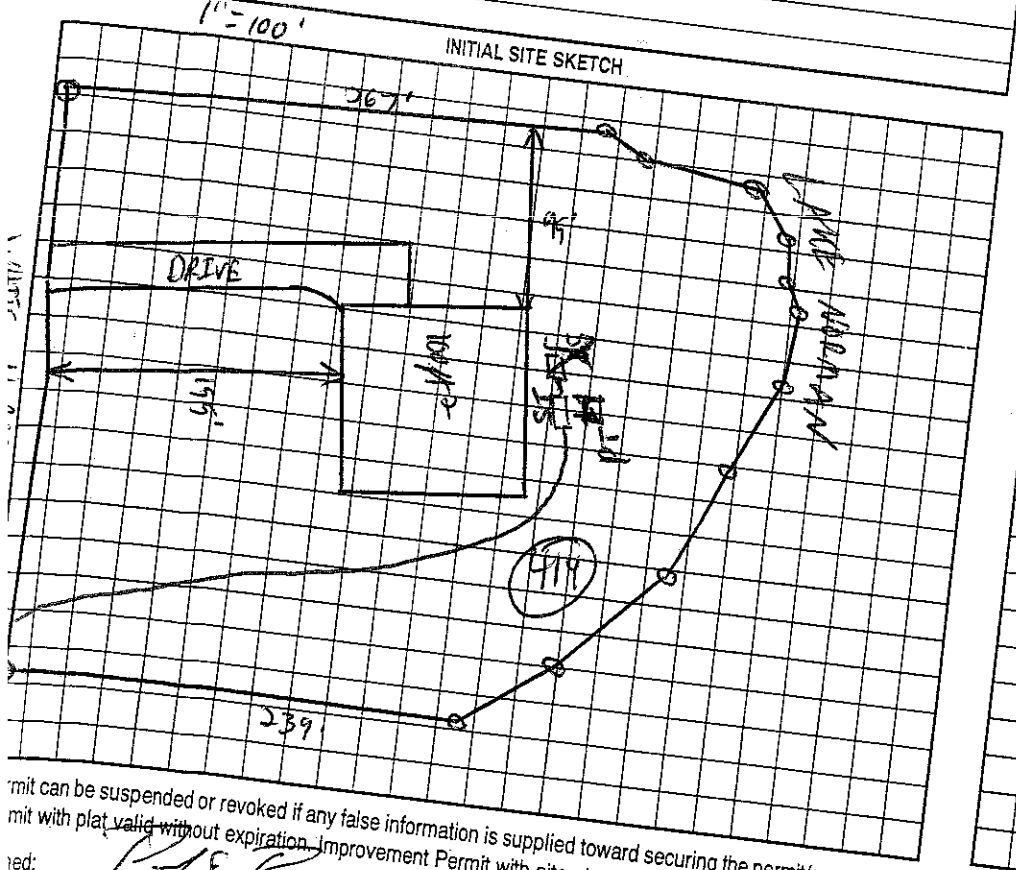

1"=50'

AS BUILT SKETCH

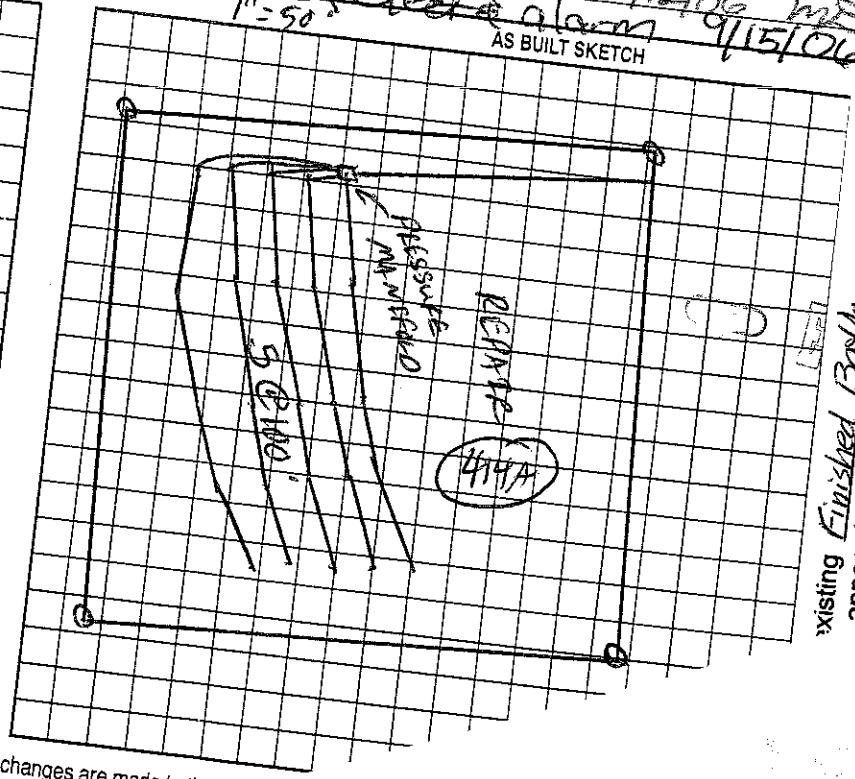

existing Finished Bath
appear to impact the existing septic system.
for
ite: 6-7-13
ICHD-Environmental Health Division
R.S.

rmit can be suspended or revoked if any false information is supplied toward securing the permit/any unauthorized changes are made to the site
mit with plat valid without expiration. Improvement Permit with site plan valid for sixty months. Authorization to Construct is valid for

ed: 1-15-04

ovement Permit by: [signature] RS date 1-21-04 Instal

orization to Construct by: [signature] RS date 1/12/00