132995

IREDELL COUNTY HEALTH DEPARTMENT

E 704-878-5305 MOORESVILLE 704-664-5281

IMPROVEMENT PERMIT / AUTHORIZATION TO CONSTRUCT / OPERATION PERMIT / EXISTING SYSTEM INSPECTI

PERMIT# 8210 | 132995 PID 4625941684 PT DATE 1/12/00

OWNER OR CONTRACTOR CRESCENT RESOURCES / DIENST PHONE: Business 6636905 JACOBS Home

ADDRESS PO BOX 1003 CHARLOTTE NC 28202

LOCATION BRAWLEY SCHOOL - TR MARSONS MILL - TL WHITE HORSE ON RT Off Ballard Rd top of hill

SUBDIVISION POINT BLOCK / SECTION 4 LOT 414 LOT AREA 5.063 SITE CLASS. PS DESIGN FLOW 600GPD L.T.A.R. .3 gal/sq ft

Septic Tank: 1500 Gallons; STB 444 Date 3-1-06

Pump Tank: 1500 Gallons; PT 477 Date 4-17-06

Pump Make: Myers Model ME50 Serial No.

Nitrification Field: No Fields 1 Square Feet 1500 Linear Feet 300

No Lines 5@100' Trench Width 36" Max Trench Bottom Depth 36" Gravel Depth N/A

☑ New System ☐ Repair System Type: I, II, III, IV, V, VI

System Description: PUMP 25% REDUCTION

Repair System Description: SAME

Maintenance Agreement Required: ☐ Yes ☑ No OFFSITE

☑ House/Mod. Home No. Bedrooms 5

☐ Mobile Home No. Bathrooms 5

☐ Business No. Employees

☐ Other


☐ Slab ☐ Crawl Space ☑ Basement w/plumbing ☐ Basement wo/plumbing

Water Supply: ☐ Individual ☐ Public ☑ Community


Comments:/Conditions: REMOVE ALL TERRACES AND BERMS

Comments:/Conditions: Checked lines 6/8/03
EZ Flow installed
Checked tanks 7/12/06 MD
Pressure, elect & alarm 9/15/06 MD

1"=100' INITIAL SITE SKETCH

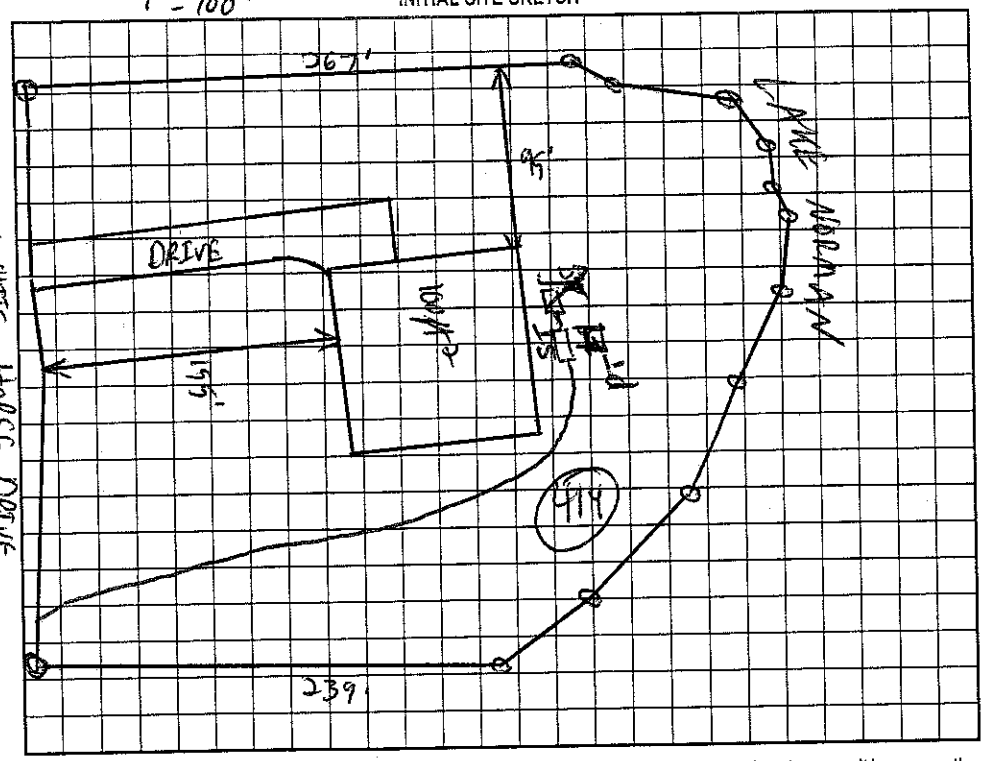

1"=50' AS BUILT SKETCH

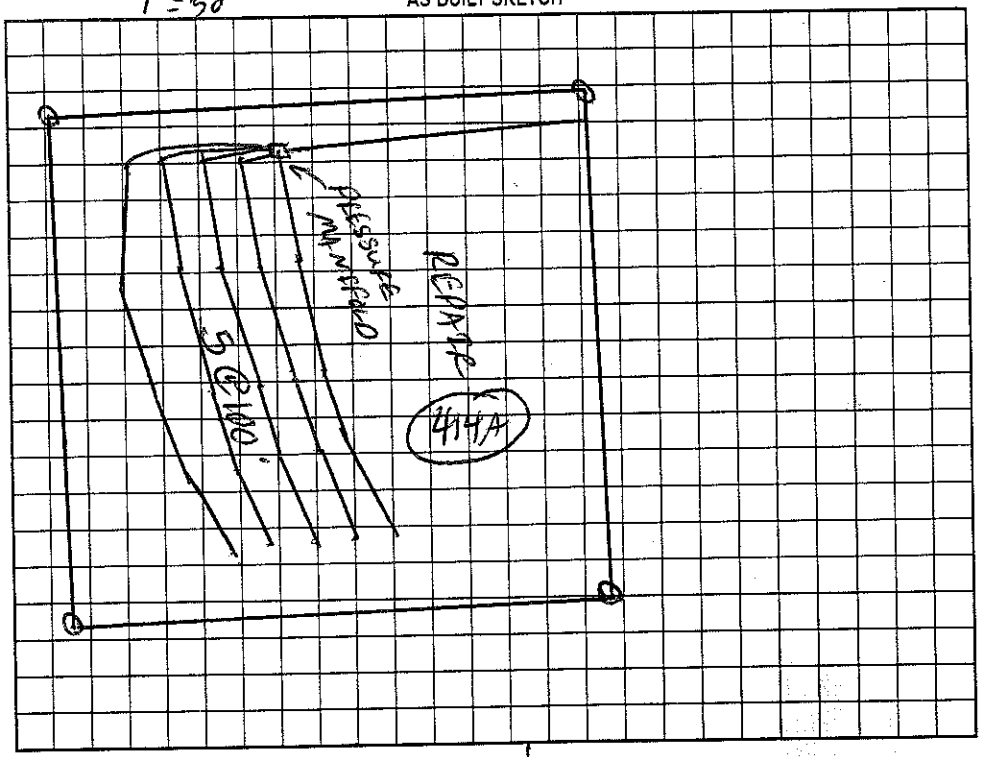

Permit can be suspended or revoked if any false information is supplied toward securing the permit/any unauthorized changes are made to the site/any unauthorized changes are made in the installation of the system. Improvement Permit with plat valid without expiration. Improvement Permit with site plan valid for sixty months. Authorization to Construct is valid for a period equal to that of Improvement Permit -- not to exceed sixty months.

Signed: P.M.F. date 1-21-00

Improvement Permit by: C. Bob Zerr RS date 1/12/00

Authorization to Construct by: Wesley Sparks RS date 12/14/05

Installed by: R&W date

Operation Permit by: Maria W Dotson RS date 9/15/06

Existing System Inspection by: date

HEALTH DEPT. COPY: WHITE OWNER COPY (FINAL): YELLOW OWNER COPY (INITIAL): PINK