IREDELL COUNTY HEALTH DEPARTMENT

STATESVILLE 5305 50.00 Paid MOORESVILLE 704-664-5281

IMPROVEMENT PERMIT / AUTHORIZATION TO CONSTRUCT / OPERATION PERMIT / EXISTING SYSTEM INSPECTION

PERMIT# 082351 PIN# ~~4625-94-1684 PT~~ 4625-78-4096 DATE 9/17/04

OWNER OR CONTRACTOR Simonini Builders PHONE: Business 704 388 9940 Home

ADDRESS 190 South Blvd Charlotte NC

LOCATION BSR, TR Marstons Mill TL White Horse on Rt

SUBDIVISION The Point BLOCK / SECTION 4 LOT 428 LOT AREA 48776 Ft² SITE CLASS PS DESIGN FLOW 600 L.T.A.R. 0.25

Septic Tank: 1500 Gallons; STB 338 Date 5-28-05

Pump Tank: 1500 Gallons; PT 477 Date 12-06-04

Pump Make: Myers Model ME50 Serial No.

Nitrification Fields No. Fields 1 Square Feet 1200 Linear Feet 400

No Lines ~~4 100'~~ 5 @ 80' Trench Width 36" Max Trench Bottom Depth 36" Gravel Depth

☒ New System ☐ Repair System Type: I, II, III, IV, V, VI

System Description: LP Panel Block

Repair System Description: Same

Maintenance Agreement Required: ☒ Yes ☐ No

☒ House/Mod. Home No. Bedrooms 5

☐ Mobile Home No. Bathrooms

☐ Business No. Employees

☐ Other


☐ Slab ☐ Crawl Space ☒ Basement w/plumbing ☐ Basement wo/plumbing

Water Supply: ☐ Individual ☐ Public ☒ Community


Comments:/Conditions: 1"=50'

Comments:/Conditions: Checked 3 of 5 lines 5/27/05
Checked other 2 lines 6/6/05
Tanks Checked 7/1/05

INITIAL SITE SKETCH

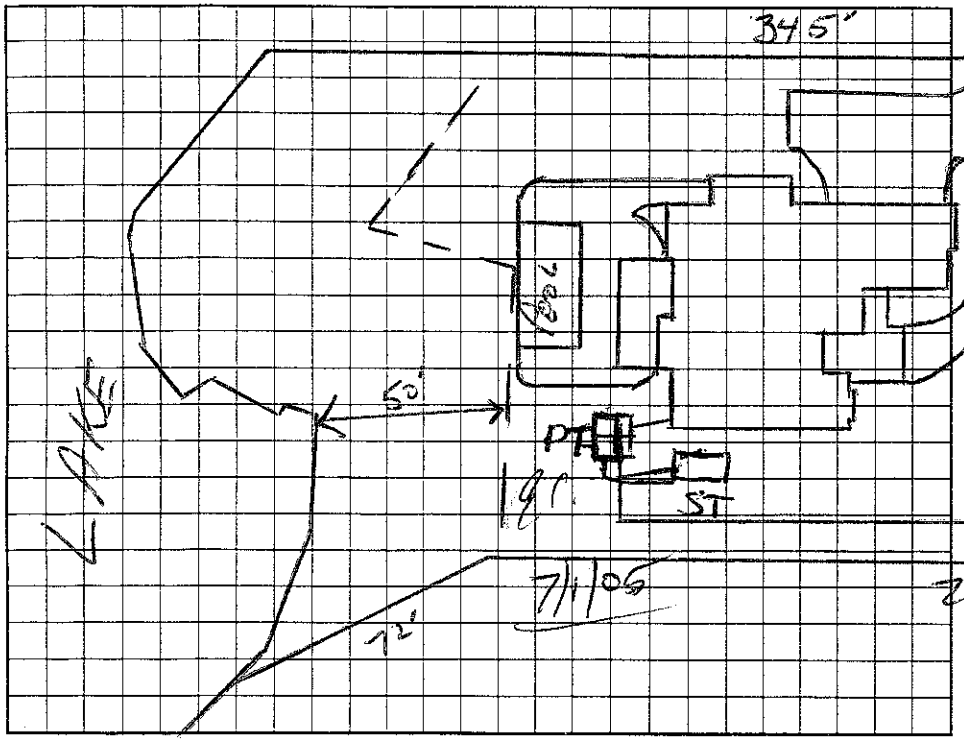

AS BUILT SKETCH

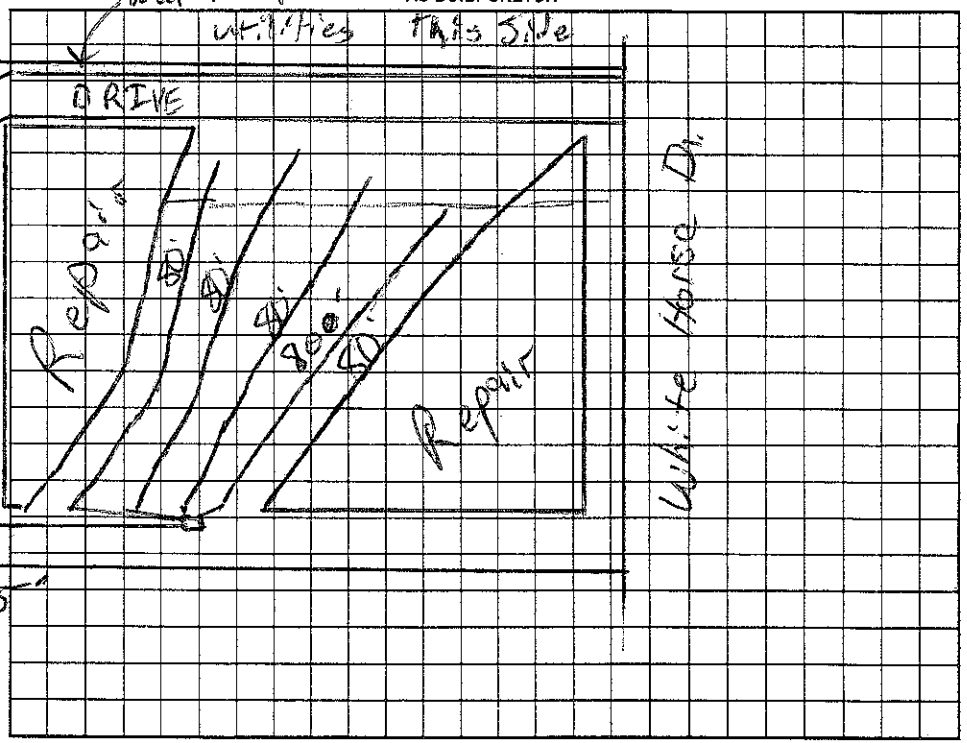

Permit can be suspended or revoked if any false information is supplied toward securing the permit/any unauthorized changes are made to the site/any unauthorized changes are made in the installation of the system. Improvement Permit with plat valid without expiration. Improvement Permit with site plan valid for sixty months. Authorization to Construct is valid for a period equal to that of Improvement Permit – not to exceed sixty months.

Signed: date 9.22.04

Improvement Permit by: RS date 9/17/04

Authorization to Construct by: RS date 9/17/04

Installed by: R&H date

Operation Permit by: Mana Dotson RS date 9/21/05

Existing System Inspection by: date

HEALTH DEPT. COPY: WHITE OWNER COPY (FINAL): YELLOW OWNER COPY (INITIAL): PINK