IREDELL COUNTY HEALTH DEPARTMENT

STATESVILLE 704-878-5305 MOORESVILLE 704-664-5281

2100

IMPROVEMENT PERMIT / AUTHORIZATION TO CONSTRUCT / OPERATION PERMIT / EXISTING SYSTEM INSPECTION

PERMIT# 82097 PIN# 4625941684 PT 4625-78-4843 DATE 1/11/00

OWNER OR CONTRACTOR CRESCENT RESOURCES / SIMONINE BLDS PHONE: Business 663 6905 JACOBS Home

ADDRESS PO BOX 1003 CHARLOTTE NC 28202

LOCATION BRAWLEY SCHOOL - TR MARSTONS MILL - TR WHITE HORSE 110

SUBDIVISION POINT BLOCK / SECTION 4 LOT 410 LOT AREA 33,313 SITE CLASS. PS DESIGN FLOW 480 GPD L.T.A.R. .39 1/42

Septic Tank: 1000+ Gallons; STB 283 Date 8-3-03

Pump Tank: 1000+ Gallons; PT 338 Date 8-5-03

Pump Make: Model Serial No.

Nitrification Field: No Fields 1 Square Feet 1200 Linear Feet 400

No Lines 4 @100' Trench Width 36" Max Trench Bottom Depth 36" Gravel Depth NA

☑ New System ☐ Repair System Type: I, II, III, IV, V, VI

System Description: PUMP 25% REDUCTION

Repair System Description: PUMP SAME

Maintenance Agreement Required: ☐ Yes ☑ No OFFSITE

☑ House/Mod. Home ☐ Mobile Home ☐ Business ☐ Other

No. Bedrooms 4 No. Bathrooms 4 No. Employees


☐ Slab ☐ Crawl Space ☑ Basement w/plumbing ☐ Basement wo/plumbing

Water Supply: ☐ Individual ☐ Public ☑ Community


Comments:/Conditions: REMOVE ALL TERRACES AND BERMS

Comments:/Conditions: Checked lines 8/6/03 MD
Checked tanks 9/15/03
Checked press, elect & alarm 10/13/03 MD

INITIAL SITE SKETCH

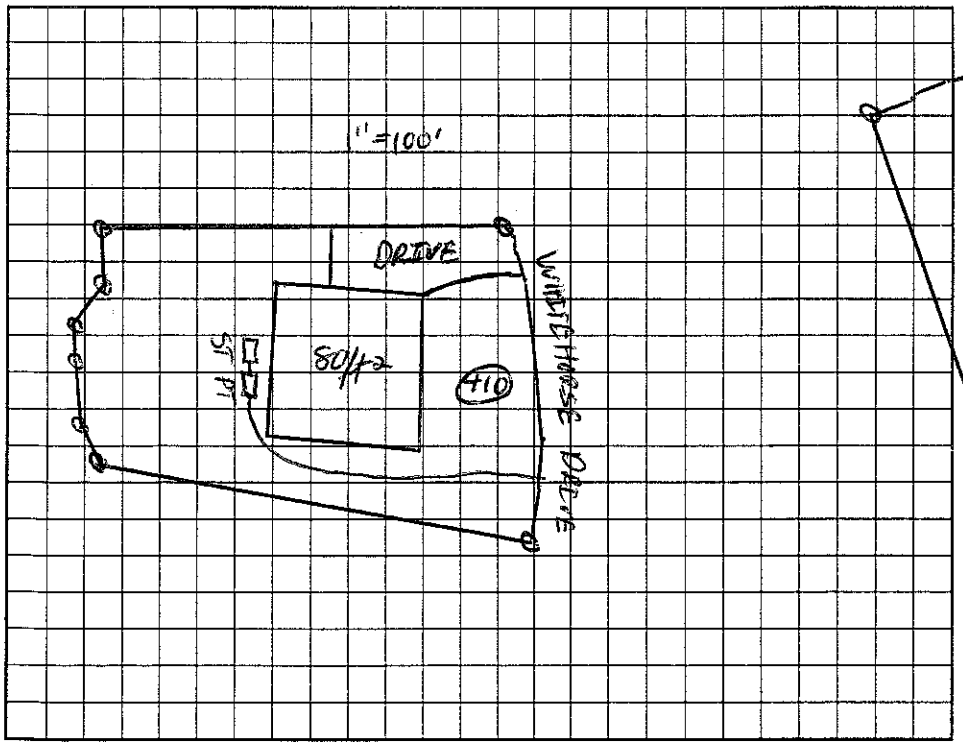

AS BUILT SKETCH 1"=50'

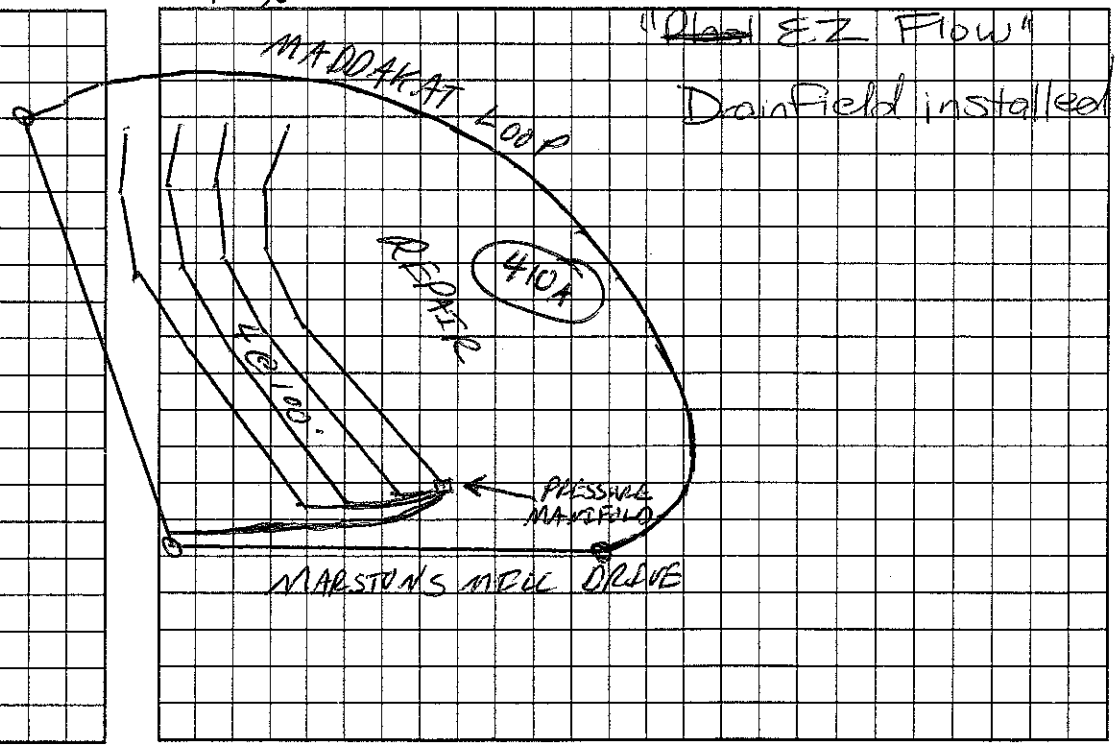

Permit can be suspended or revoked if any false information is supplied toward securing the permit/any unauthorized changes are made to the site/any unauthorized changes are made in the installation of the system. Improvement Permit with plat valid without expiration. Improvement Permit with site plan valid for sixty months. Authorization to Construct is valid for a period equal to that of Improvement Permit – not to exceed sixty months.

Signed: date 1-21-00 Installed by: R&H Inc RS

Improvement Permit by: C. Blyth RS date 1/11/00 Operation Permit by: Marvin H Dotson RS date 10/13/03

Authorization to Construct by: C. Blyth RS date 2/20/03 Existing System Inspection by: date

HEALTH DEPT. COPY: WHITE OWNER COPY (FINAL): YELLOW OWNER COPY (INITIAL): PINK