IREDELL COUNTY HEALTH DEPARTMENT

STATESVILLE 704-878-5305 MOORESVILLE 704-664-5281

IMPROVEMENT PERMIT / AUTHORIZATION TO CONSTRUCT / OPERATION PERMIT / EXISTING SYSTEM INSPECTION

PERMIT# 82352 / 31674 PIN# 4625944684 PT 4625 78 6121 DATE 12/30/99

OWNER OR CONTRACTOR CRESCENT RESOURCES / ~~[illegible]~~ DIBBLE PHONE: Business 663-6905 Jacobs Home

ADDRESS PO BOX 1003 CHARLOTTE NC 28202

LOCATION BRAWLEY SCHOOL - JR MARSTONS MILL - JL WHITEHORSE ON CT 153 White Horse

SUBDIVISION POINT BLOCK / SECTION 4 LOT 429 LOT AREA 52878 sf SITE CLASS. PS DESIGN FLOW 480GPD L.T.A.R. ~.3 gal/sf/d

Septic Tank: ~~1000~~ 1500 Gallons; STB 338 Date 4/17/06

Pump Tank: 1000+ Gallons; PT 283 Date 3/19/06

Pump Make: Goulds Model WE0S12H4 Serial No.

Nitrification Field: No Fields 1 Square Feet 1320 Linear Feet 440

No Lines 4@100' Trench Width 36" Max Trench Bottom Depth 36" Gravel Depth N/A

☑ New System ☐ Repair System Type: I, II, (III), IV, V, VI

System Description: PUMP 25% REDUCTION

Repair System Description: SAME

Maintenance Agreement Required: ☐ Yes ☑ No

☑ ~~House/Mod. Home~~ No. Bedrooms 4

☐ Mobile Home No. Bathrooms 4

☐ Business No. Employees

☐ Other


☐ Slab ☐ Crawl Space ☑ Basement w/plumbing ☐ Basement wo/plumbing

Water Supply:
☐ Individual
☐ Public
☑ ~~Community~~


Comments:/Conditions: REMOVE ALL TERRACES AND BERMS

Comments:/Conditions: 1-1/4" PM. INSTALLED

INITIAL SITE SKETCH 1"=50'

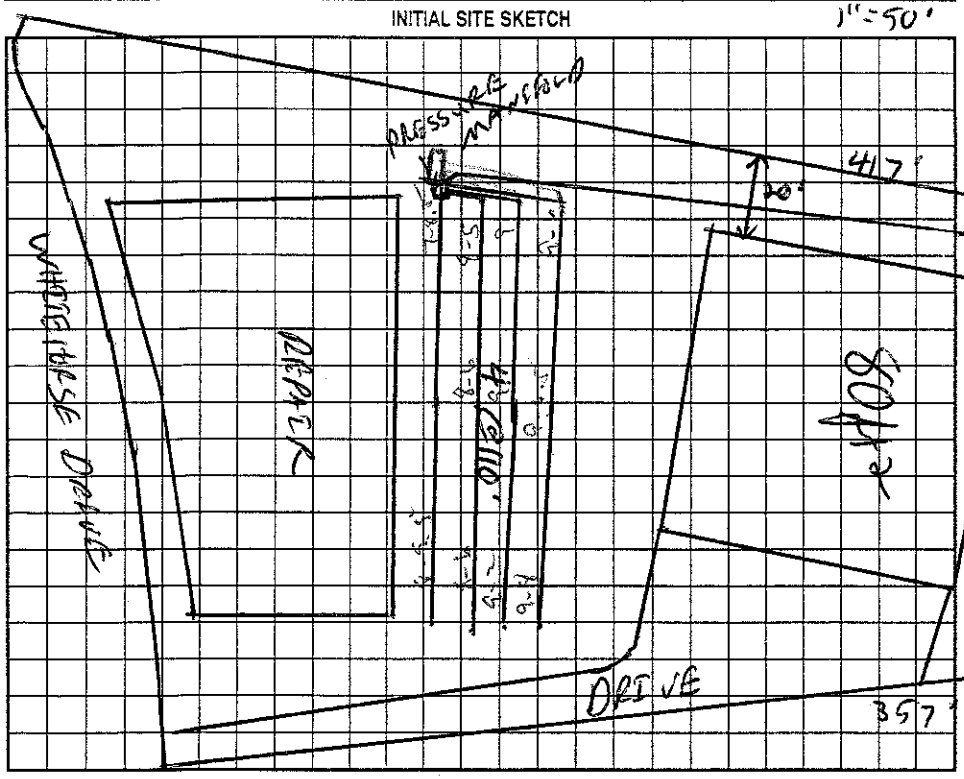

AS BUILT SKETCH

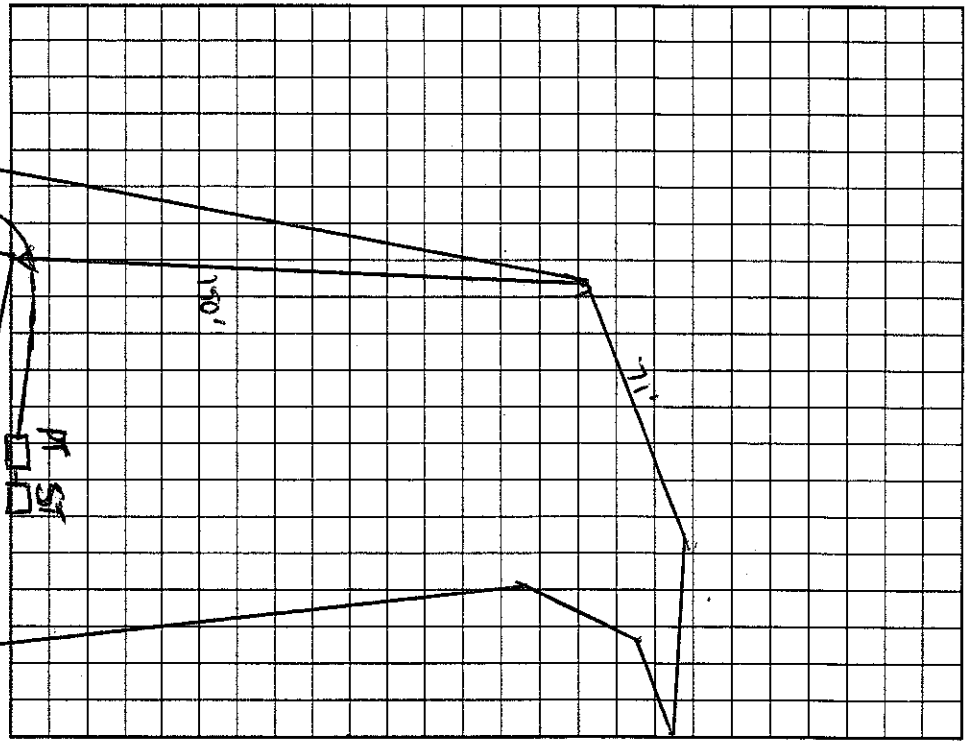

Permit can be suspended or revoked if any false information is supplied toward securing the permit/any unauthorized changes are made to the site/any unauthorized changes are made in the installation of the system. Improvement Permit with plat valid without expiration. Improvement Permit with site plan valid for sixty months. Authorization to Construct is valid for a period equal to that of Improvement Permit – not to exceed sixty months.

Signed: [signature] date 1-21-00 Installed by: Dobson + Sons.

Improvement Permit by: C. Bly Jones RS date 12/30/99 Operation Permit by: Judy McKittrick date 7-28-06

Authorization to Construct by: Whitney Sparks RS. date 9/29/05 Existing System Inspection by: date

HEALTH DEPT. COPY: WHITE OWNER COPY (FINAL): YELLOW OWNER COPY (INITIAL): PINK