IREDELL COUNTY HEALTH DEPARTMENT

Statesville Office (704) 878-5305 Mooresville Office (704) 660-3625 PERMIT # 210923

IMPROVEMENT PERMIT / AUTHORIZATION TO CONSTRUCT / OPERATION PERMIT (EXISTING SYSTEM)

PIN # 4625 78 6536

APPLICANT: STEVEN PUCKETT APPLICANT ADDRESS: 138 WHITE HORSE DR. MOORESVILLE, NC 28117

SITE ADDRESS: 138 WHITE HORSE DR. PHONE: ALT. PHONE: 704-968-7177 MARK CORRELL

SITE DIRECTIONS: BRAWLEY SCHOOL TR MARSTONS MILL DR. TL WHITE HORSE, 2ND DRIVE ON (R) # 138

SUBDIVISION: POINT SECTION: 4 LOT # 412 LOT AREA: 1.14 DESIGN FLOW: 480 L.T.A.R.: .25

Septic Tank	1500 (gal)	STB	Date	☐ New System ☐ Repair ☐ Expansion	System Type: I II (III) IV V VI	☑ Residence	No. Bedrooms 4
Pump Tank	1500 (gal)	PT	Date	System Description:	SFE 412A - MARSTONS MILL DR	☐ Business	No. Persons
Pump Make		Model	Serial #	Repair System Description:	SAME	☐ Other	No. Employees
# Nitrification Fields	1	# Lines 4	Linear Ft: 480	Maintenance Agreement Required:	☐ YES ☐ NO	☐ Slab	☐ Crawl Space
Trench Width	3	Max. Trench Bottom Depth 3	Gravel Depth N/A		☐ GRAVITY ☐ PRESSURE	☑ Basement w/plumbing	☐ Basement w/o plumbing


Water Supply: ☐ Private ☐ Public ☑ Community

Comments / Conditions:

Proposed Fireplace will set on existing patio. This is 10' from S/T and P/T. Will not impact system.

INITIAL SITE SKETCH

AS BUILT SKETCH

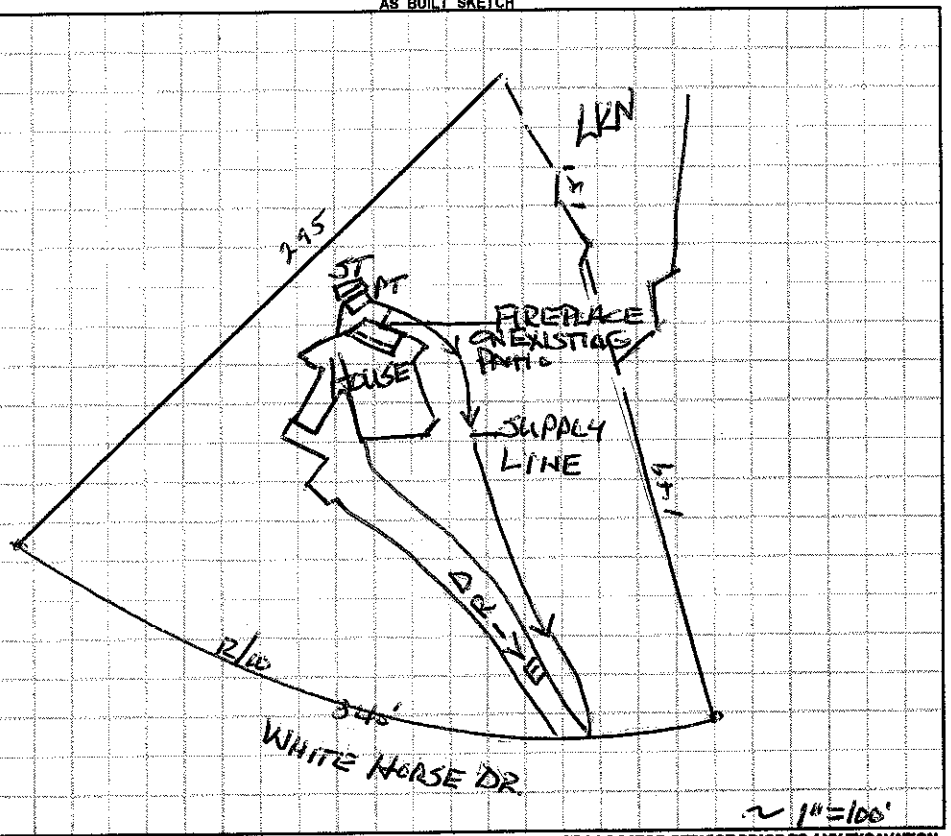

Permit can be suspended or revoked if any false information is supplied toward securing the permit / any unauthorized changes are made to the site / any unauthorized changes are made in the installation of the system. **CONTACT A LOCATOR SERVICE PRIOR TO ANY EXCAVATION**

☐ **IMPROVEMENT PERMIT** *with plat valid without expiration.* ☐ **IMPROVEMENT PERMIT** *with site plan valid for 60 mos.* ☐ **AUTHORIZATION TO CONSTRUCT** *valid for period equal to IMPROVEMENT PERMIT--not to exceed 60 mo.*

Owner / Applicant Signature: Date: 7-6-15 Installed by:

IMPROVEMENT PERMIT by: Date: OPERATION PERMIT by: Date: 6/26/2015

AUTHORIZATION TO CONSTRUCT by: Date: Existing System Inspected by: Wesley Sparks REHS Date:

Health Dept. Copy - WHITE Applicant (Final Approval) - YELLOW Applicant (Conditional Approval) - PINK