IREDELL COUNTY HEALTH DEPARTMENT

STATESVILLE 704-878-5305 MOORESVILLE 704-664-5281

IMPROVEMENT PERMIT / AUTHORIZATION TO CONSTRUCT / OPERATION PERMIT / EXISTING SYSTEM INSPECTION

PERMIT# 082099/126828 PIN# 4625941684 PT DATE 1/12/00

OWNER OR CONTRACTOR CRESCENT RESOURCES/Elrod Custom Homes PHONE: Business 6636905 JACOBS Home

ADDRESS PO BOX 1003 CHARLOTTE NC 28202

LOCATION BRAWLEY SCHOOL - TR MARSTONS MILL - TR WHITE HORSE - ON LT

SUBDIVISION POINT BLOCK / SECTION 4 LOT 412 LOT AREA 29700 SITE CLASS. PS DESIGN FLOW 480 GPD L.T.A.R. .25 gal/ft²

Septic Tank: ~~1000~~ 1500 Gallons; STB 331 Date 10/15/99

Pump Tank: 1000 T Gallons; PT 293 Date 10/14/99

Pump Make: Goulds Model WE4E1012 Serial No.

Nitrification Field: No Fields 1 Square Feet 1360 Linear Feet 480

No Lines 4@120' Trench Width 36" Max Trench Bottom Depth 36" Gravel Depth N/A

☑ New System ☐ Repair System Type: I, II, III, IV, V, VI

System Description: PUMP 25% REDUCTION

Repair System Description: SAME

Maintenance Agreement Required: ☐ Yes ☑ No OFFSITE

☑ House/Mod. Home No. Bedrooms 4

☐ Mobile Home No. Bathrooms 4

☐ Business No. Employees

☐ Other

☐ Slab ☐ Crawl Space ☑ Basement w/plumbing ☐ Basement wo/plumbing

Water Supply: ☐ Individual ☐ Public ☑ ~~Community~~


Comments:/Conditions: REMOVE ALL TERRACES AND BERMS

Comments:/Conditions: Expand ① on Ballston on ⑫


Drainlines Pressure Manifold

Inspection port installed

INITIAL SITE SKETCH 1"=100'

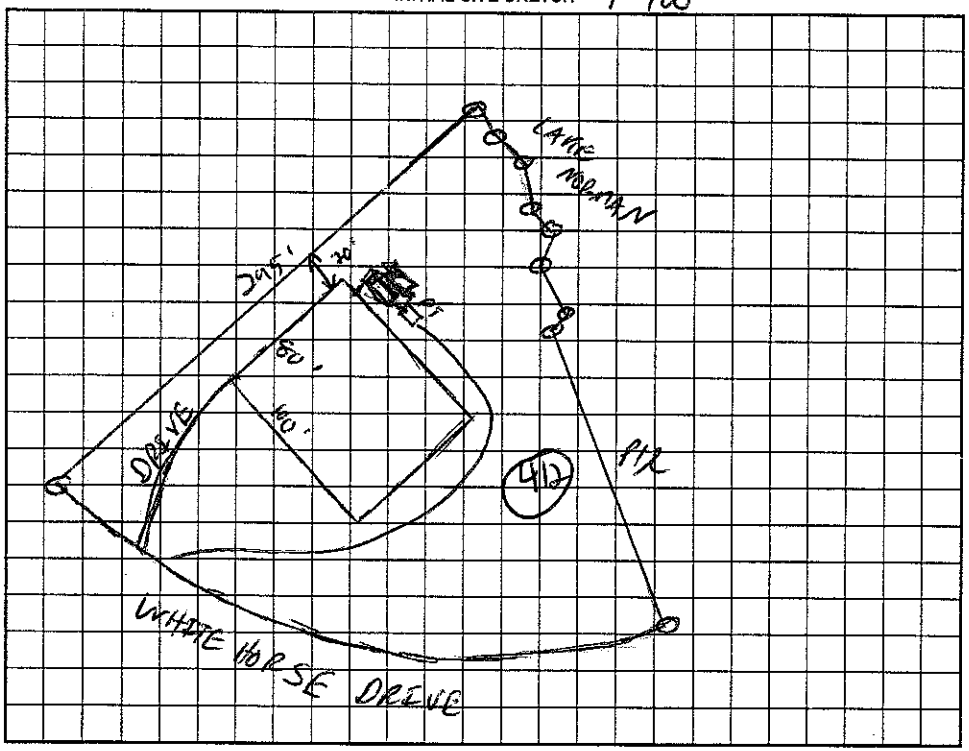

1"=50' AS BUILT SKETCH

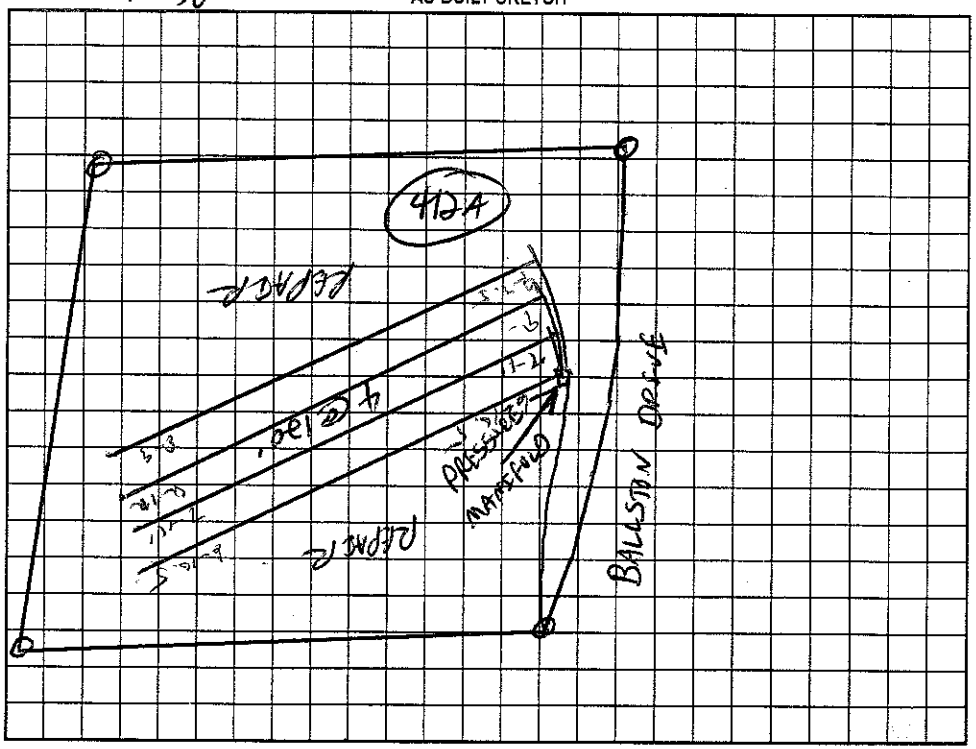

Permit can be suspended or revoked if any false information is supplied toward securing the permit/any unauthorized changes are made to the site/any unauthorized changes are made in the installation of the system. Improvement Permit with ~~plat~~ valid ~~without expiration~~. Improvement Permit with site plan valid for sixty months. Authorization to Construct is valid for a period equal to that of Improvement Permit – not to exceed sixty months.

Signed: [signature] date 1-21-00 Installed by: Onbrayer & Sons

Improvement Permit by: [signature] RS date 1/12/00 Operation Permit by: Wendy Sperhac RS. date 1/23/06

Authorization to Construct by: [signature] RS date 2/9/05 Existing System Inspection by: date

HEALTH DEPT. COPY: WHITE OWNER COPY (FINAL): YELLOW OWNER COPY (INITIAL): PINK

1-800-532-7355.asp