IREDELL COUNTY HEALTH DEPARTMENT

STATESVILLE 704-878-5305 MOORESVILLE 704-664-5281

IMPROVEMENT PERMIT / AUTHORIZATION TO CONSTRUCT / OPERATION PERMIT / EXISTING SYSTEM INSPECTION

PERMIT# 82464 PIN# ~~4625941689 PT~~ 4625788436 DATE 1/5/00

OWNER OR CONTRACTOR CRESCENT RESOURCES / GM Helms Const. PHONE: Business 663-6905 SACOBS Home

ADDRESS PO BOX 1003 CHARLOTTE NC 28202

LOCATION BRAWLEY SCHOOL - TR MARSONS MILL - TL WHITE HORSE - CORNER OF BALLSTON DRIVE

SUBDIVISION POINT BLOCK / SECTION 4 LOT 481 LOT AREA 38511 SITE CLASS. PS DESIGN FLOW 480 GPD L.T.A.R. .39 ac/ac

Septic Tank: ~~1000~~ + 1500 Gallons; STB 338 Date 5/13/01

Pump Tank: 1000 + Gallons; PT Date

Pump Make: Model Serial No.

Nitrification Field: No Fields 1 Square Feet 1200 Linear Feet 400

No Lines 4@100' Trench Width 36" Max Trench Bottom Depth 36" Gravel Depth N/A

☑ New System ☐ Repair System Type: I, II, III, IV, V, VI

System Description: ~~PUMP~~ 25% REDUCTION

Repair System Description: LP PANEL

Maintenance Agreement Required: ☐ Yes ☑ No

☑ House/Mod. Home No. Bedrooms 4

☐ Mobile Home No. Bathrooms 4

☐ Business No. Employees

☐ Other


☐ Slab ☑ Crawl Space ☐ Basement w/plumbing ☐ Basement wo/plumbing

Water Supply: ☐ Individual ☐ Public ☑ ~~Community~~

Comments:/Conditions: REMOVE ALL TERRACES AND BERMS
6/19/2001 Reinspect, System CAN be gravity Feed
SYSTEM SHALL BE PUMPED UNLESS AFTER HOUSE IS BUILT OR BEING BUILT THAT GRAVITY CAN BE ACHIEVED


Comments:/Conditions: CRAWL ONLY
12-11-00 Received site & house plan - appear substantially in compliance w/ I.P.

INITIAL SITE SKETCH

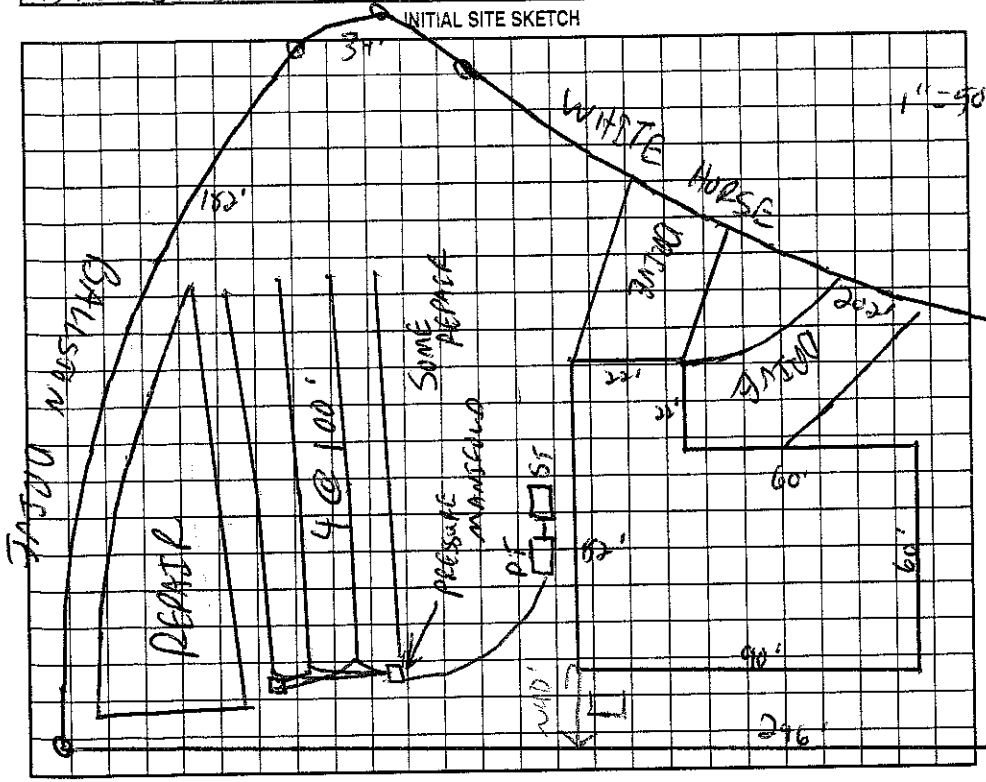

AS BUILT SKETCH

Gravity installed 7/11/01

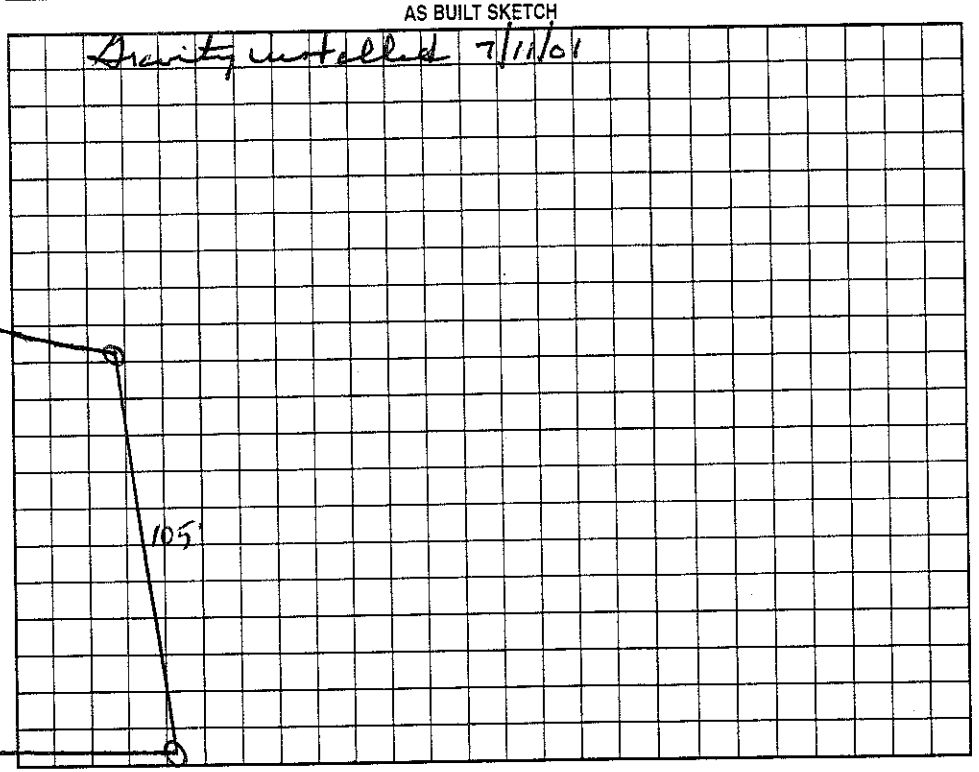

Permit can be suspended or revoked if any false information is supplied toward securing the permit/any unauthorized changes are made to the site/any unauthorized changes are made in the installation of the system. Improvement Permit with plat valid without expiration. Improvement Permit with site plan valid for sixty months. Authorization to Construct is valid for a period equal to that of Improvement Permit – not to exceed sixty months.

Signed: date 1-25-00 Installed by: R+H

Improvement Permit by: C. Bryan Ramsey RS date 1/5/00 Operation Permit by: Wesley Sparks RS. date 7/11/01

Authorization to Construct by: date 12/11/00 Existing System Inspection by: date

HEALTH DEPT. COPY: WHITE OWNER COPY (FINAL): YELLOW OWNER COPY (INITIAL): PINK