$50 3:30

IREDELL COUNTY HEALTH DEPARTMENT

STATESVILLE 704-878-5305 MOORESVILLE 704-664-5281

IMPROVEMENT PERMIT / AUTHORIZATION TO CONSTRUCT / OPERATION PERMIT / EXISTING SYSTEM INSPECTION

PERMIT# 82463 PIN# ~~4625 94 1684 PT~~ 4625-78-9476 DATE 7/2/02

OWNER OR CONTRACTOR G. M. Helms Const. PHONE: Business 704-895-9000 Home

ADDRESS 18518 Statesville Rd. Cornelius NC 28031

LOCATION Brawley Sch, TR Marstons Mill, TL White Horse, TL Bolton or Lt.

SUBDIVISION Point BLOCK / SECTION 4 LOT 480 LOT AREA 33,214 SITE CLASS. S DESIGN FLOW 480 L.T.A.R. 0.3

Septic Tank: 1000 Gallons; STB 338 Date 7-22-02
Pump Tank: 1000 Gallons; PT 27 Date 12-6-02
Pump Make: Model Serial No.
Nitrification Field: No Fields 1 Square Feet 810 Linear Feet 270
No Lines 3@90' Trench Width 36" Max Trench Bottom Depth 36" Gravel Depth —

☒ New System ☐ Repair System Type: I, II, III, (IV) V, VI
System Description: LP Panel Block
Repair System Description: Same
Maintenance Agreement Required: ☒ Yes ☐ No


☒ House/Mod. Home No. Bedrooms 4
☐ Mobile Home No. Bathrooms 4
☐ Business No. Employees
☐ Other
☐ Slab ☒ Crawl Space ☐ Basement w/plumbing ☐ Basement wo/plumbing

Water Supply:
☐ Individual
☐ Public
☒ Community


Comments:/Conditions:

Comments:/Conditions: 3/16" hole drilled, 60 total panels used, Checked tanks 1-14-03

INITIAL SITE SKETCH

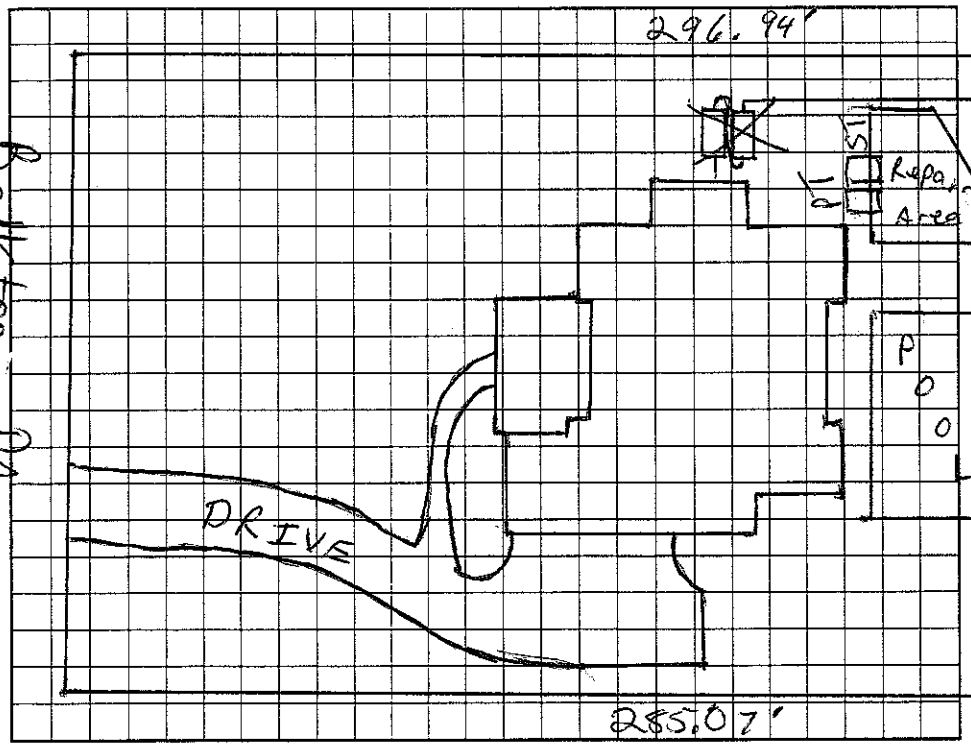

AS BUILT SKETCH

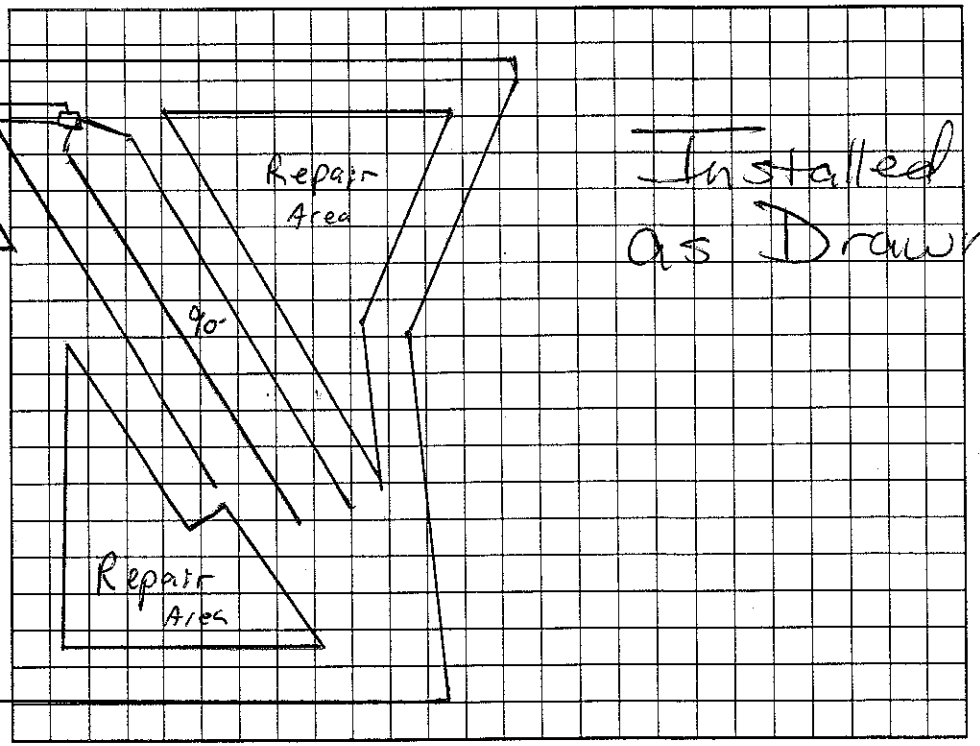

Permit can be suspended or revoked if any false information is supplied toward securing the permit/any unauthorized changes are made to the site/any unauthorized changes are made in the installation of the system. Improvement Permit with plat valid without expiration. Improvement Permit with site plan valid for sixty months. Authorization to Construct is valid for a period equal to that of Improvement Permit – not to exceed sixty months.

Signed: [signature] date 11/4/02 Installed by: R & H Inc RS

Improvement Permit by: [signature] RS date 7/2/02 Operation Permit by: [signature] RS date 12/5/2003

Authorization to Construct by: [signature] RS date 7/2/02 Existing System Inspection by: date

HEALTH DEPT. COPY: WHITE OWNER COPY (FINAL): YELLOW OWNER COPY (INITIAL): PINK