IREDELL COUNTY HEALTH DEPARTMENT

STATESVILLE 704-878-5305 MOORESVILLE 704-664-5281

IMPROVEMENT PERMIT / AUTHORIZATION TO CONSTRUCT / OPERATION PERMIT / EXISTING SYSTEM INSPECTION

PERMIT# 81921 PIN# 4625941684 PT 4625-79-0442 DATE 1/10/00

OWNER OR CONTRACTOR CRESCENT RESOURCES / Tom Stevenson Bar-Mar PHONE: Business 663805 JACOBS Home

ADDRESS PO BOX 1003 CHARLOTTE NC 28202 105 Wellfleet

LOCATION BRAWLEY SCHOOL - TR MARSTONS MILL - TR WHITE HORSE - TR TUCKNUCK - TL WELLFLEET AT END

SUBDIVISION POINT BLOCK / SECTION 4 LOT 403 LOT AREA 31,791 SITE CLASS. PS DESIGN FLOW 480 GPD L.T.A.R. .3 gpd/ft²

Septic Tank: 1000 + Gallons; STB 335 Date 1-19-03

Pump Tank: 1000 + Gallons; PT 27 Date 1-25-03

Pump Make: Model Serial No.

Nitrification Field: No Fields 1 Square Feet 1200 Linear Feet 400

No Lines 4 @ 100' Trench Width 36" Max Trench Bottom Depth 36" Gravel Depth N/A

☑ New System ☐ Repair System Type: I, II, (III), IV, V, VI

System Description: PUMP 25% REDUCTION

Repair System Description: SAME

Maintenance Agreement Required: ☐ Yes ☑ No OFFSITE

☑ House/Mod. Home No. Bedrooms 4

☐ Mobile Home No. Bathrooms 4

☐ Business No. Employees

☐ Other

☐ Slab ☐ Crawl Space ☑ Basement w/plumbing ☐ Basement wo/plumbing


Water Supply: ☐ Individual ☐ Public ☑ Community

Comments:/Conditions: REMOVE ALL TERRACES AND BERMS Drainfield off Bay Harbour (next to "The Harbour" entrance)

Comments:/Conditions: Tanks Checked 3/4/03 Plans reviewed 7/29/02 Lines checked 4/15/03


INITIAL SITE SKETCH

1" = 100'

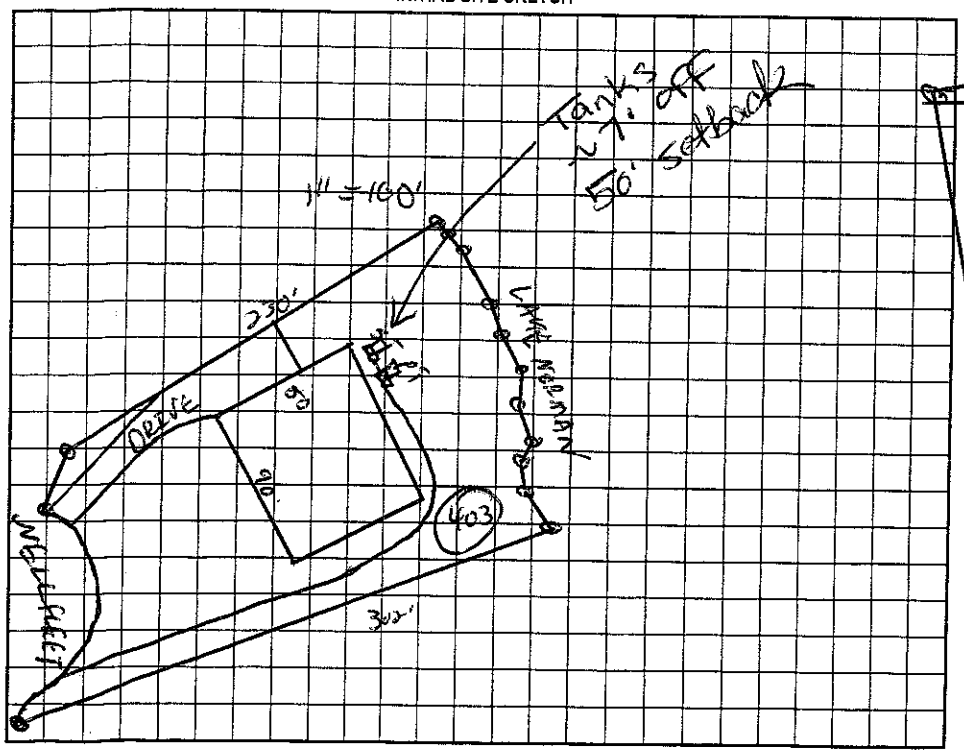

AS BUILT SKETCH

1" = 50'

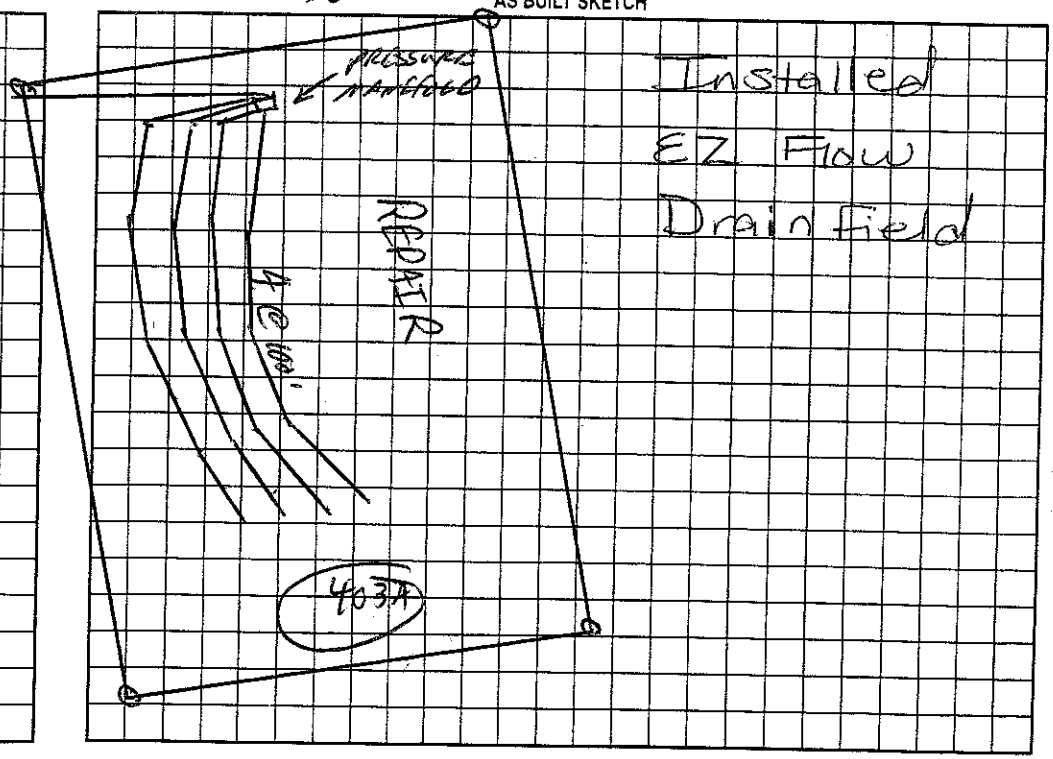

Permit can be suspended or revoked if any false information is supplied toward securing the permit/any unauthorized changes are made to the site/any unauthorized changes are made in the installation of the system. Improvement Permit with plat valid without expiration. Improvement Permit with site plan valid for sixty months. Authorization to Construct is valid for a period equal to that of Improvement Permit – not to exceed sixty months.

Signed: date 1-21-03 Installed by: R & H INC.

Improvement Permit by: RS date 1/10/00 Operation Permit by: RS date 6/16/03

Authorization to Construct by: RS date 7/29/02 Existing System Inspection by: date

HEALTH DEPT. COPY: WHITE OWNER COPY (FINAL): YELLOW OWNER COPY (INITIAL): PINK