IREDELL COUNTY HEALTH DEPARTMENT

STATESVILLE 704-878-5305 MOORESVILLE 704-664-5281

IMPROVEMENT PERMIT / AUTHORIZATION TO CONSTRUCT / OPERATION PERMIT / EXISTING SYSTEM INSPECTION

11681 11681 PERMIT# ~~11681~~ ~~81929~~ PIN# ~~4625 94 1684~~ 4625-79-1515 DATE 8/10/05

OWNER OR CONTRACTOR Michael L Ryon PHONE: Business 361-1084 Home

ADDRESS 215 Crystal Cir. Mooresville, NC. 28117

LOCATION 111 Wellfleet Court, 1100 TR Mastons Mill TR White House TR Tuckaseegee TR Wellfleet on R

SUBDIVISION Point I BLOCK / SECTION 4 LOT 402 LOT AREA 40,322 SITE CLASS PS DESIGN FLOW 600 L.T.A.R. .25

Septic Tank: 1500 Gallons; STB 338 Date 9-3-05
Pump Tank: 1500 Gallons; PT 471 Date 8-18-05
Pump Make: Myers Model ME500S Serial No.
Nitrification Fields No Fields 1 Square Feet 1200 Linear Feet 400
No Lines 8 Trench Width 3' Max Trench Bottom Depth 3'

☒ New System ☐ Repair System Type: I, II, III, (IV) V, VI
System Description: LP - PBPS
Repair System Description: OFFSITE EASEMENT 402A
Maintenance Agreement Required: ☐ Yes ☐ No
Gravel Depth NA

☐ House/Mod. Home No. Bedrooms 5
☐ Mobile Home No. Bathrooms 4
☐ Business No. Employees
☐ Other
☐ Slab ☐ Crawl Space ☒ Basement w/plumbing ☐ Basement wo/plumbing


Water Supply: ☐ Individual ☐ Public ☒ Community POINT

Comments:/Conditions: Remove all terraces and berms in drainfield area.


Comments:/Conditions: Checked tanks & lines 10/4/05 MD
Installed & Panel lines
Pressure, elect & alarm checked 1/30/06
Note. Landscaping over Drainfield not done at time of Fing inspection

(1" = 50')

INITIAL SITE SKETCH

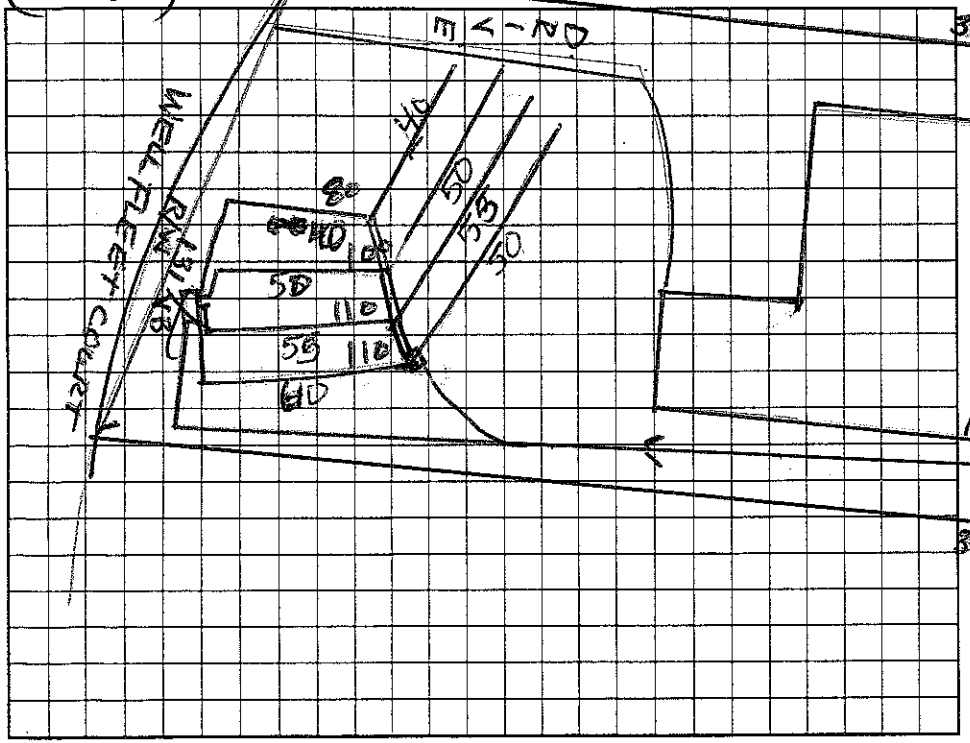

AS BUILT SKETCH

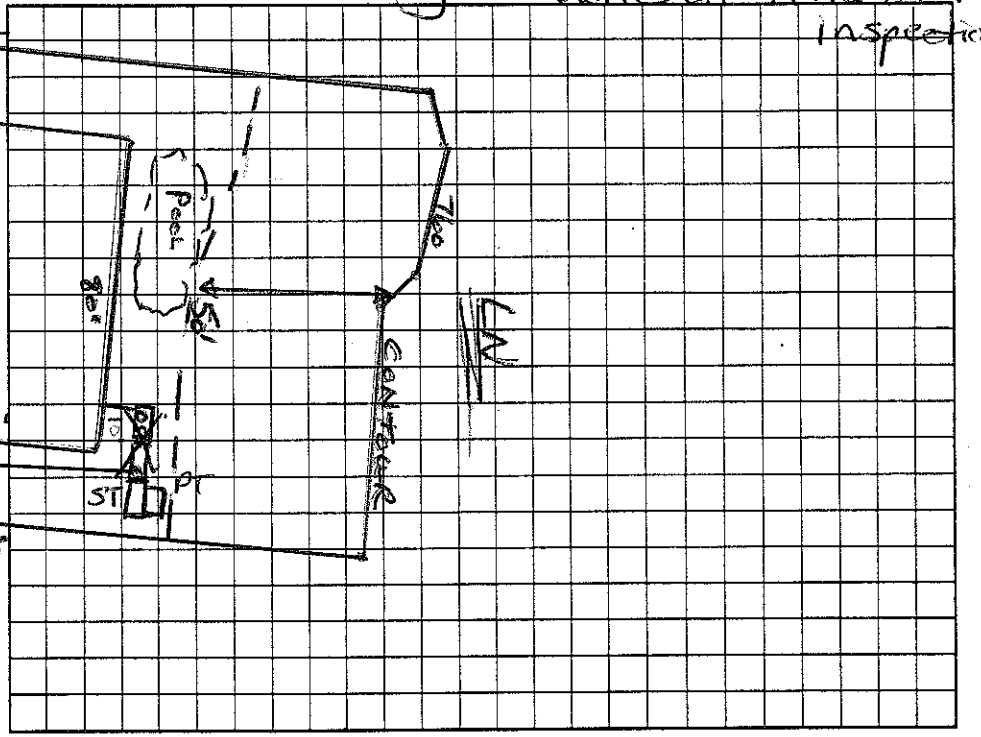

Permit can be suspended or revoked if any false information is supplied toward securing the permit/any unauthorized changes are made to the site/any unauthorized changes are made in the installation of the system. Improvement Permit with plat valid without expiration. Improvement Permit with site plan valid for sixty months. Authorization to Construct is valid for a period equal to that of Improvement Permit – not to exceed sixty months.

Signed: X date

Improvement Permit by: Wesley Sparks RS. date 8/10/05

Authorization to Construct by: Wesley Sparks RS date 8/25/05

Installed by: R&H

Operation Permit by: Maria H Dotson RS date 1/30/06

Existing System Inspection by: date

HEALTH DEPT. COPY: WHITE OWNER COPY (FINAL): YELLOW OWNER COPY (INITIAL): PINK