IREDELL COUNTY HEALTH DEPARTMENT

STATESVILLE 704-878-5305 MOORESVILLE 704-664-5281

IMPROVEMENT PERMIT / AUTHORIZATION TO CONSTRUCT / OPERATION PERMIT / EXISTING SYSTEM INSPECTION

PERMIT# 8/924 1/6183 PIN# 4625941684 PT Shaun 309-6810 4625793168 DATE 1/11/00

OWNER OR CONTRACTOR CRESCENT RESOURCES / L. Shaun Ogden PHONE: Business 663 6905 JACOBS Home

ADDRESS PO BOX 1003 CHARLOTTE NC 28202

LOCATION BRAWLEY SCHOOL - TR MARSTONS MILL - R WHITE HORSE TR TUCKERNUCK - ON LT

SUBDIVISION POINT BLOCK / SECTION 4 LOT 406/406A LOT AREA 50.164 SITE CLASS. PS DESIGN FLOW 600 GPD L.T.A.R. .3 gpd/ft²

Septic Tank: 1500 Gallons; STB 383 Date 8/7/05

Pump Tank: 1500 Gallons; PT 283 Date 8/7/05

Pump Make: Goulds Model WE-20 Z-NC Serial No. 8/1/05

Nitrification Field: No Fields 1 Square Feet 1500 Linear Feet 500

No Lines 4@125' Trench Width 36" Max Trench Bottom Depth 36" Gravel Depth N/A

☑ New System ☐ Repair System Type: I, II, III, IV, V, VI

System Description: Offsite PUMP 25% REDUCTION

Repair System Description: STONE

Maintenance Agreement Required: ☐ Yes ☑ No

☑ House/Mod. Home No. Bedrooms 5

☐ Mobile Home No. Bathrooms 5

☐ Business No. Employees

☐ Other


☐ Slab ☐ Crawl Space ☑ Basement w/plumbing ☐ Basement wo/plumbing

Water Supply: ☐ Individual ☐ Public ☑ Community


Comments:/Conditions: REMOVE ALL TERRACES AND BERMS
Reviewed Building plans 9/25/03, essentially in Compliance with Improvement Permit.
WHITE HORSE Septic Drainfield located offsite.

Comments:/Conditions: 22 Flow installed

INITIAL SITE SKETCH

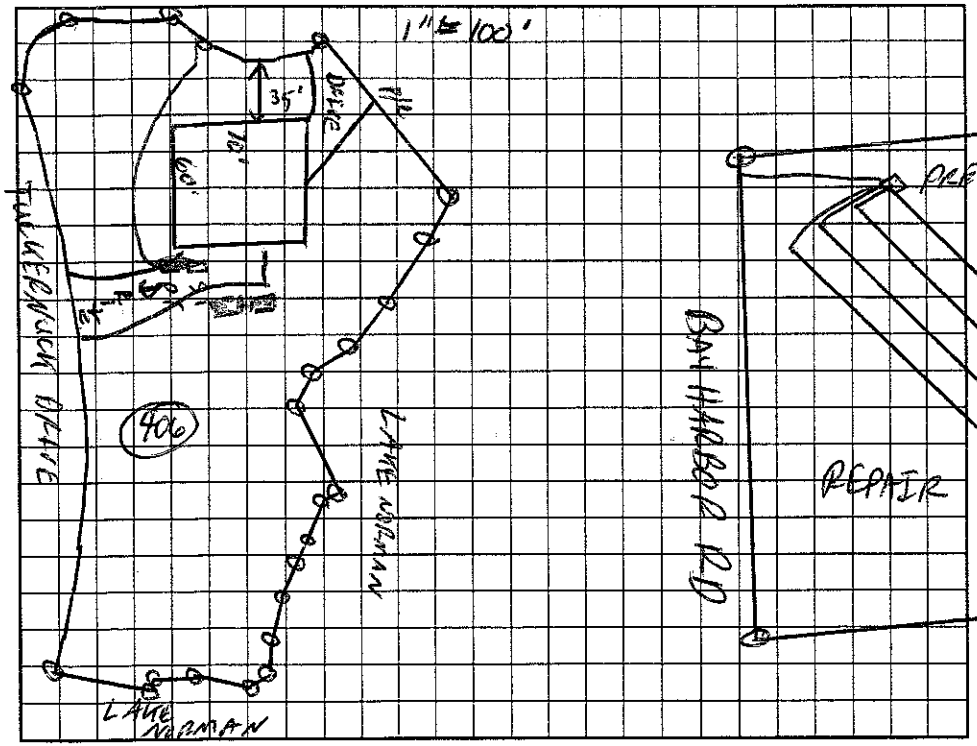

AS BUILT SKETCH

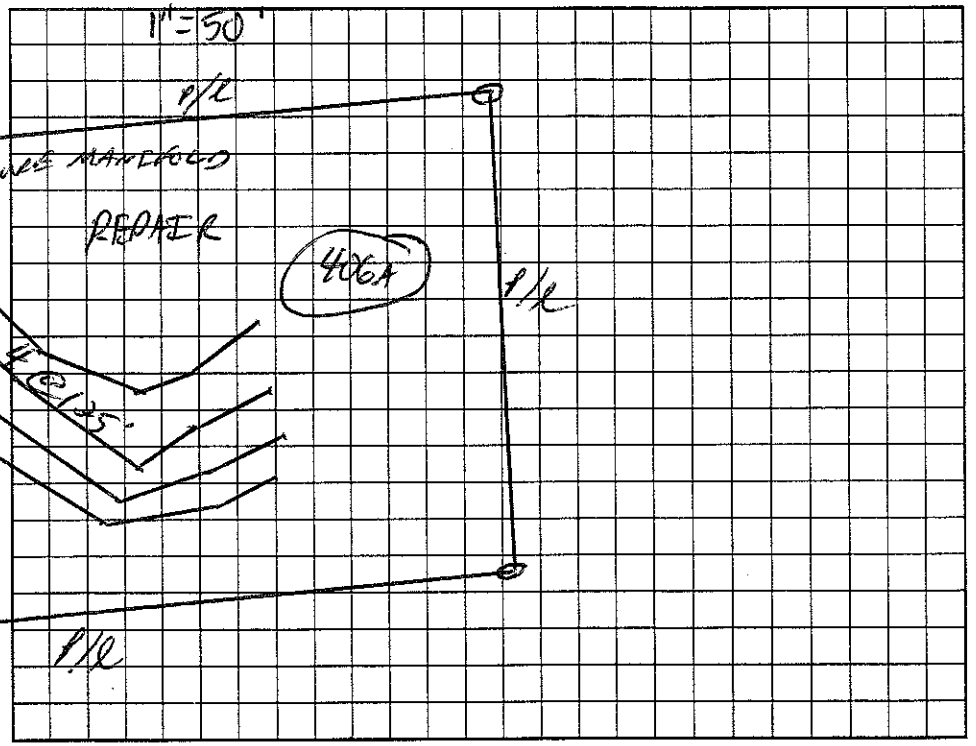

Permit can be suspended or revoked if any false information is supplied toward securing the permit/any unauthorized changes are made to the site/any unauthorized changes are made in the installation of the system. Improvement Permit with plat valid without expiration. Improvement Permit with site plan valid for sixty months. Authorization to Construct is valid for a period equal to that of Improvement Permit – not to exceed sixty months.

Signed: _____ date 1-21-00 Installed by: Richard Blumenthal

Improvement Permit by: C. Bob Zen RS date 1/11/00 Operation Permit by: Wesley Speaks RS date 11/8/05

Authorization to Construct by: Mahalath H. Dotson RS date 9/25/03 Existing System Inspection by: _____ date _____

HEALTH DEPT. COPY: WHITE OWNER COPY (FINAL): YELLOW OWNER COPY (INITIAL): PINK