IREDELL COUNTY HEALTH DEPARTMENT

STATESVILLE 704-878-5305 50.00 Pd MOORESVILLE 704-664-5281

IMPROVEMENT PERMIT / AUTHORIZATION TO CONSTRUCT / OPERATION PERMIT / EXISTING SYSTEM INSPEC

124707

PERMIT# 124707 ~~8493~~ PIN# 4625 94 1684 ~~4627~~ 4625793464 DATE 10/8/04

OWNER OR CONTRACTOR Kenneth Becker Homes PHONE: Business 704-662-6460 Home

ADDRESS PO Box 3398 Mooresville NC. 28117

LOCATION 1100 TR Marston Mill TR White Horse TR Tuckaway at corner R Wellpoint

SUBDIVISION Point BLOCK / SECTION 4 LOT 405 LOT AREA 29,353 SITE CLASS. PS DESIGN FLOW 600 L.T.A.R. .3

Septic Tank: 1500 Gallons; STB 338 Date 7-2-05 ☒ New System ☐ Repair System Type: I, II, III, IV, V, VI

Pump Tank: 1500 Gallons; PT 477 Date 2-28-05 System Description: PM - 2570 Redwood 405A

Pump Make Goulds Model 1500 Serial No. 500 Repair System Description: 16" PPBPS 405A

Nitrification Field: No. Fields 1 Square Feet ~~334~~ Linear Feet ~~334~~ Maintenance Agreement Required: ☐ Yes ☒ No

No Lines 5@100 Trench Width @3 Max Trench Bottom Depth 3' Gravel Depth NA

☒ House/Mod. Home ☐ Mobile Home ☐ Business ☐ Other — No. Bedrooms 5 — No. Bathrooms 4 — No. Employees

☐ Slab ☐ Crawl Space ☒ Basement w/plumbing ☐ Basement wo/plumbing

Water Supply: ☐ Individual ☐ Public ☒ Community POINT


Comments:/Conditions: 5@100' 1500 FT² 500 LF

Note: 8/9/05 Tanks Checked 15ft side slope from house MD


Comments:/Conditions:

Pump - Goulds WE1ST2HU Serial #: F05C367

1" = 100' INITIAL SITE SKETCH

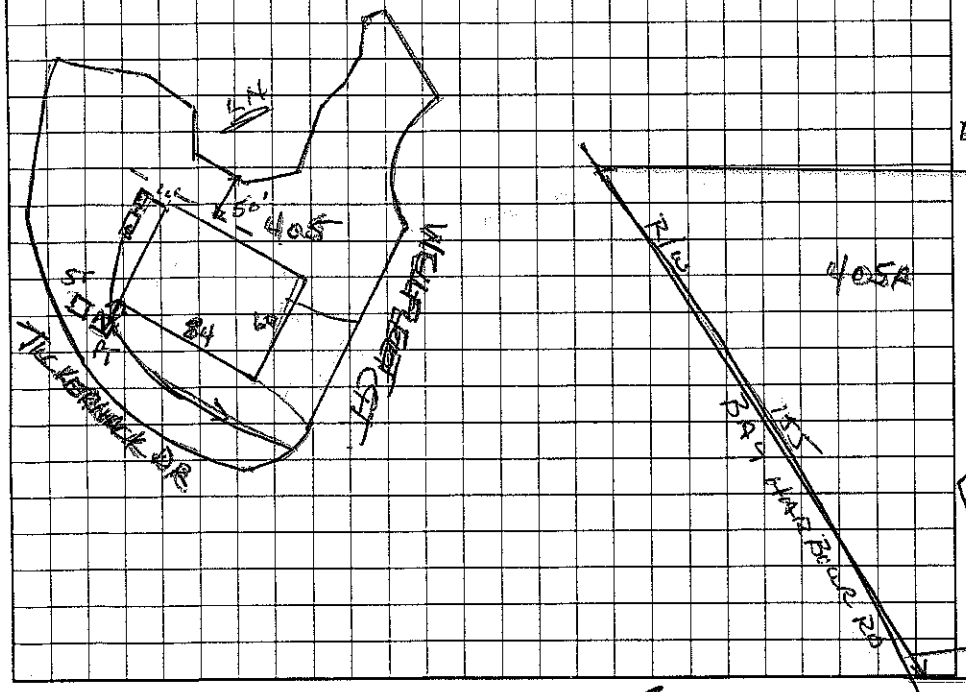

1" = 50' AS BUILT SKETCH

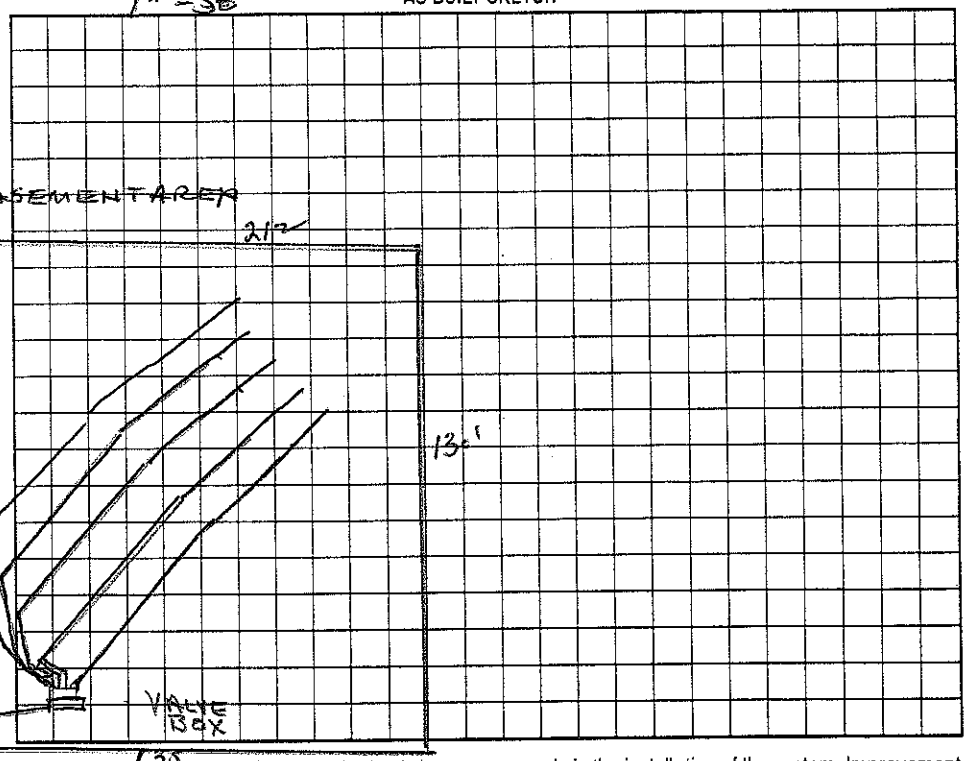

Permit can be suspended or revoked if any false information is supplied toward securing the permit/any unauthorized changes are made to the site/any unauthorized changes are made in the installation of the system. Improvement Permit with plat valid without expiration. Improvement Permit with site plan valid for sixty months. Authorization to Construct is valid for a period equal to that of Improvement Permit – not to exceed sixty months.

Signed: [signature] date 10/8/04 Installed by: Hallmon

Improvement Permit by: Wesley Sparks RS date 10/8/04 Operation Permit by: [signature] RS date 9/7/05

Authorization to Construct by: Wesley Sparks RS date 10/8/04 Existing System Inspection by: date

HEALTH DEPT. COPY: WHITE OWNER COPY (FINAL): YELLOW OWNER COPY (INITIAL): PINK