117620

IREDELL COUNTY HEALTH DEPARTMENT

IMPROVEMENT PERMIT / AUTHORIZATION TO CONSTRUCT / OPERATION PERMIT / EXISTING SYSTEM INSPECTION

ST...LLE 704-878-5305 MOORESVILLE 704-664-5...

PERMIT# 81841 PIN# 4625941684 PT 4625-79-4671 DATE 12/10/99

OWNER OR CONTRACTOR CRESCENT RESOURCES / AUGUSTA HOMES PHONE: Business 603-6805 JACOBS Home

ADDRESS PO BOX 1003 CHARLOTTE NC 28202

LOCATION BRAWLEY SCHOOL RD - TR MARSONS MILL - TR WHITE HORSE - TR TUCKERMUCK - ON RT ON CORNER

SUBDIVISION POINT BLOCK / SECTION 4 LOT 390 LOT AREA 36,307 SITE CLASS. PS DESIGN FLOW 480 GPD L.T.A.R. .3 gal/sq ft

Septic Tank: 1000+ Gallons; STB 338 Date 7-3-04

Pump Tank: 1000+ Gallons; PT Date

Pump Make: Model Serial No.

Nitrification Field: No Fields 1 Square Feet 1260 Linear Feet 420

No Lines 6@70' Trench Width 36" Max Trench Bottom Depth 36" Gravel Depth N/A

☑ New System ☐ Repair System Type: I, II, III, IV, V, VI

System Description: GRAVITY 25% REDUCTION

Repair System Description: PUMP PANEL

Maintenance Agreement Required: ☐ Yes ☑ No

☑ House/Mod. Home No. Bedrooms 4

☐ Mobile Home No. Bathrooms 4

☐ Business No. Employees

☐ Other

☐ Slab ☑ Crawl Space ☐ Basement w/plumbing ☐ Basement wo/plumbing


Water Supply: ☐ Individual ☐ Public ☑ Community

Comments:/Conditions: REMOVE ALL TERRACES AND BERMS.


Comments:/Conditions: Checked lower 3 lines @ ST 8/6/04 MD
Checked upper 3 lines 8/10/04 MD
Checked TD-box 8/11/04

1"=90'

INITIAL SITE SKETCH

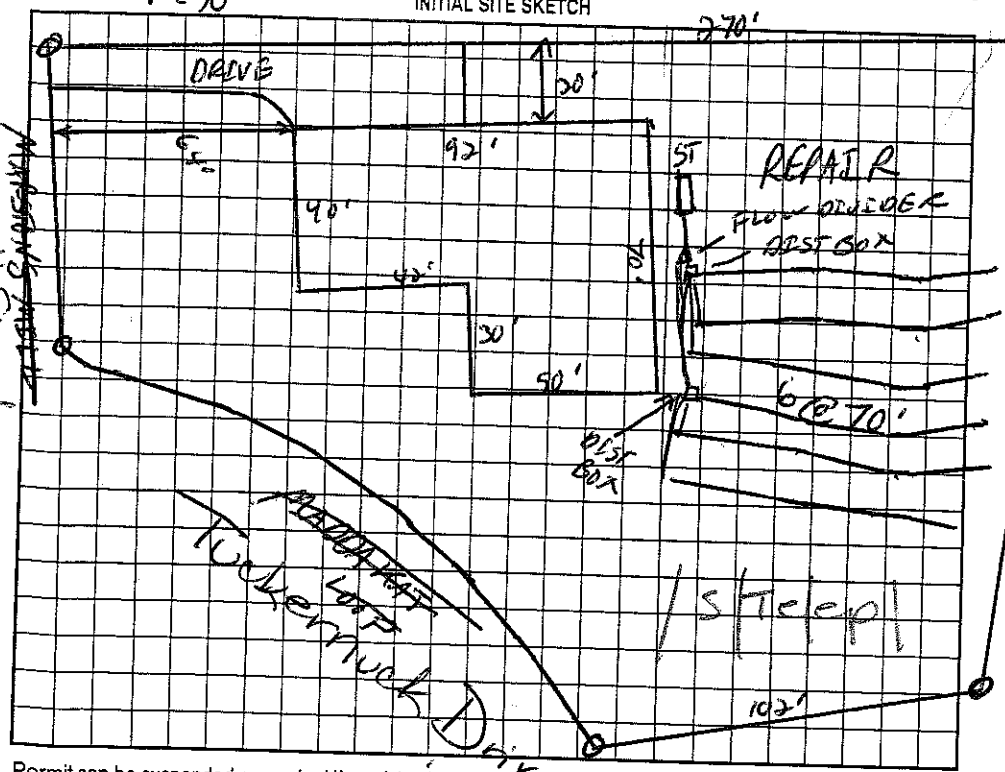

AS BUILT SKETCH

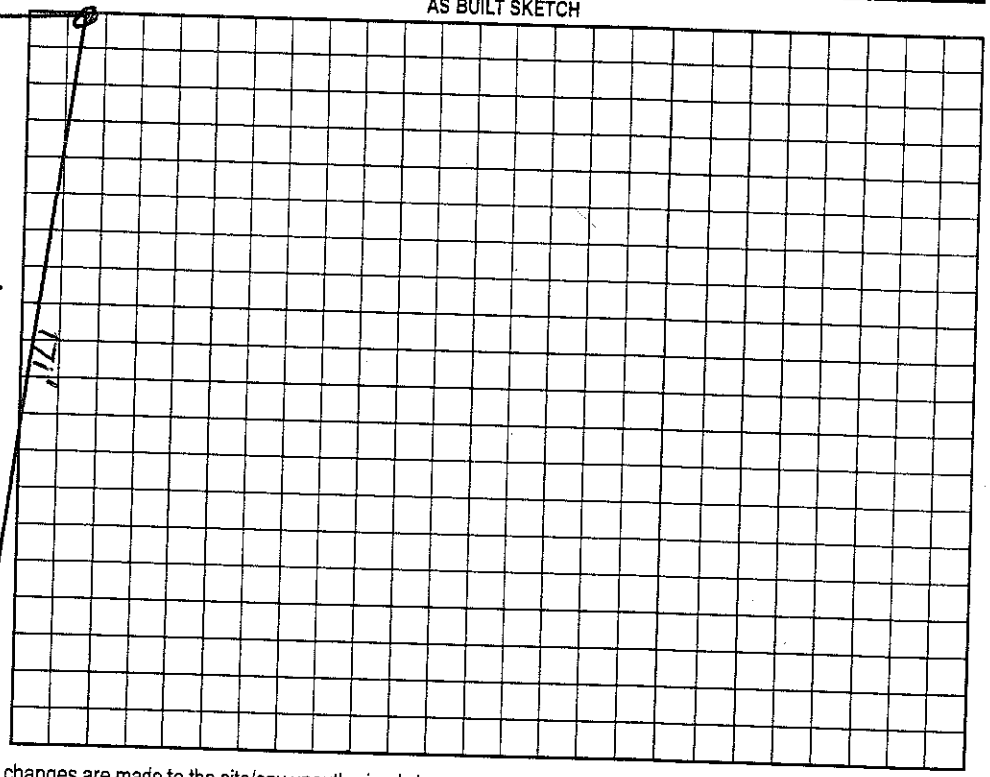

Permit can be suspended or revoked if any false information is supplied toward securing the permit/any unauthorized changes are made to the site/any unauthorized changes are made in the installation of the system. Improvement Permit with plat valid without ~~expiration~~. Improvement Permit with site plan valid for sixty months. Authorization to Construct is valid for a period equal to that of Improvement Permit – not to exceed sixty months.

Signed: P.K. P date 1-21-00

Improvement Permit by: C. B... RS date 12/10/99

Authorization to Construct by: ... RS date 12/4/03

Installed by: R & H

Operation Permit by: ... RS date 8/11/04

Existing System Inspection by: date

HEALTH DEPT. COPY: WHITE OWNER COPY (FINAL): YELLOW OWNER COPY (INITIAL): PINK