IREDELL COUNTY HEALTH DEPARTMENT

STATESVILLE 704-878-5305 MOORESVILLE 704-664

10:00

IMPROVEMENT PERMIT / AUTHORIZATION TO CONSTRUCT / OPERATION PERMIT / EXISTING SYSTEM ECTIO

PERMIT# 81844 PIN# 4625947168 4 PT 4625-79-6925 DATE 12/13/99

OWNER OR CONTRACTOR CRESCENT RESOURCES/AUGUSTA HOMES PHONE: Business 663-6905 JACOBS Home

ADDRESS PO BOX 003 CHARLOTTE NC 28202

LOCATION BRAWLEY SCHOOL - TR MARSTON MILL - TR WHITE HORSE - TR TUCKER NUCK DRIVE - TR WELLFLEET CT AT

SUBDIVISION POSEY T BLOCK / SECTION 4 LOT 393 LOT AREA 41,272 SITE CLASS. PS DESIGN FLOW 450GPD L.T.A.R. .30PD/FT = En

Septic Tank: 1000+ Gallons; STB 338 Date 9-16-03

Pump Tank: 1000+ Gallons; PT Date

Pump Make: Model Serial No.

Nitrification Field: No Fields 1 Square Feet 1200 Linear Feet 400

No Lines 4 @ 100' Trench Width 36" Max Trench Bottom Depth 36" Gravel Depth

☑ New System ☐ Repair System Type: I, II, III, IV, V, VI

System Description: GRAVITY 25% REDUCTION

Repair System Description: PUMP PANEL

Maintenance Agreement Required: ☐ Yes ☑ No

☑ House/Mod. Home No. Bedrooms 4

☐ Mobile Home No. Bathrooms 4

☐ Business No. Employees

☐ Other

☐ Slab ☑ Crawl Space ☐ Basement w/plumbing ☐ Basement wo/plumbing

Water Supply: ☐ Individual ☐ Public ☑ Community


Comments:/Conditions: REMOVE OLD TERRACES AND BERMS

5 @ 80'


Comments:/Conditions:

Installed EZ Flow Drainfield in 5 - 80' lines

INITIAL SITE SKETCH

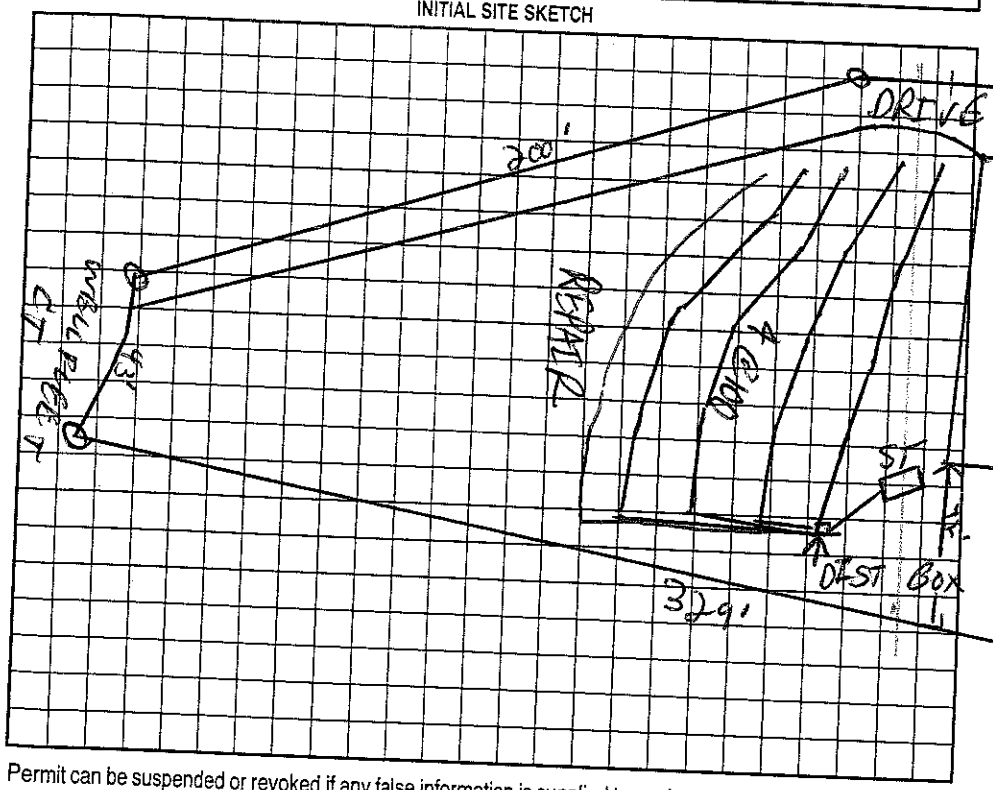

AS BUILT SKETCH 1"=50'

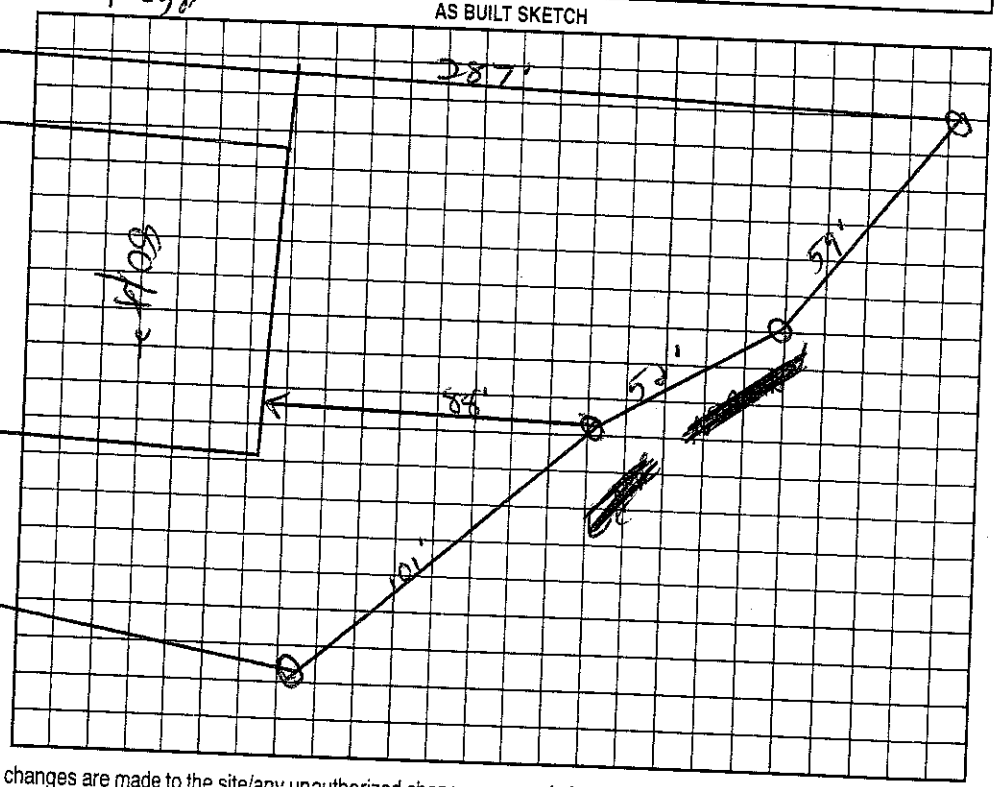

Permit can be suspended or revoked if any false information is supplied toward securing the permit/any unauthorized changes are made to the site/any unauthorized changes are made in the installation of the system. Improvement Permit with ~~plat~~ valid without expiration. Improvement Permit with site plan valid for sixty months. Authorization to Construct is valid for a period equal to that of Improvement Permit – not to exceed sixty months.

Signed: Ken G. date 1-21-00 Installed by: R & H

Improvement Permit by: C. R. RS date 12/13/99 Operation Permit by: Marvin H. Dotson RS date 10/24/03

Authorization to Construct by: C. RS date 1/8/03 Existing System Inspection by: date

HEALTH DEPT. COPY: WHITE OWNER COPY (FINAL): YELLOW OWNER COPY (INITIAL): PINK