IREDELL COUNTY HEALTH DEPARTMENT

STATESVILLE 704-878-5305 — MOORESVILLE 704-664-5281

IMPROVEMENT PERMIT / AUTHORIZATION TO CONSTRUCT / OPERATION PERMIT / EXISTING SYSTEM INSPECTION

Existing Syst

PERMIT# 110984 PIN# 4625798481 Dan Goetz DATE 1-22-2003

OWNER OR CONTRACTOR Arcadia Homes Inc PHONE: Business (704) 201-7181 Home

ADDRESS P.O. Box 471941 Charlotte, NC 28247

LOCATION 118 Madda Ket Loop-Brawley School Rd TR Marstons Mill TR maddakat Leap on right

SUBDIVISION The Point BLOCK / SECTION 4 LOT 387 LOT AREA 54450 ft2 SITE CLASS PS DESIGN FLOW 600 gpd L.T.A.R. .3

Septic Tank: 1500 Gallons; STB Date

Pump Tank: 1500 Gallons; PT Date

Pump Make: Model Serial No.

Nitrification Field: No Fields 1 Square Feet 1050 Linear Feet 350'

No Lines 4 Trench Width 36" Max Trench Bottom Depth 30" Gravel Depth N/A

☒ New System ☐ Repair System Type: I, II, III, IV, V, VI

System Description: Pump-LP- Danet Blk

Repair System Description: Same

Maintenance Agreement Required: ☐ Yes ☐ No

☒ House/Mod. Home ☐ Mobile Home ☐ Business ☐ Other

No. Bedrooms 5 No. Bathrooms 5.5 No. Employees

☐ Slab ☐ Crawl Space ☒ Basement w/plumbing ☐ Basement wo/plumbing


Water Supply: ☐ Individual ☒ Public ☒ Community

Comments:/Conditions:

Comments:/Conditions: House has not been lived in yet. Existing Septic appears to be functioning okay at time of inspection.

Scale 1:50


INITIAL SITE SKETCH

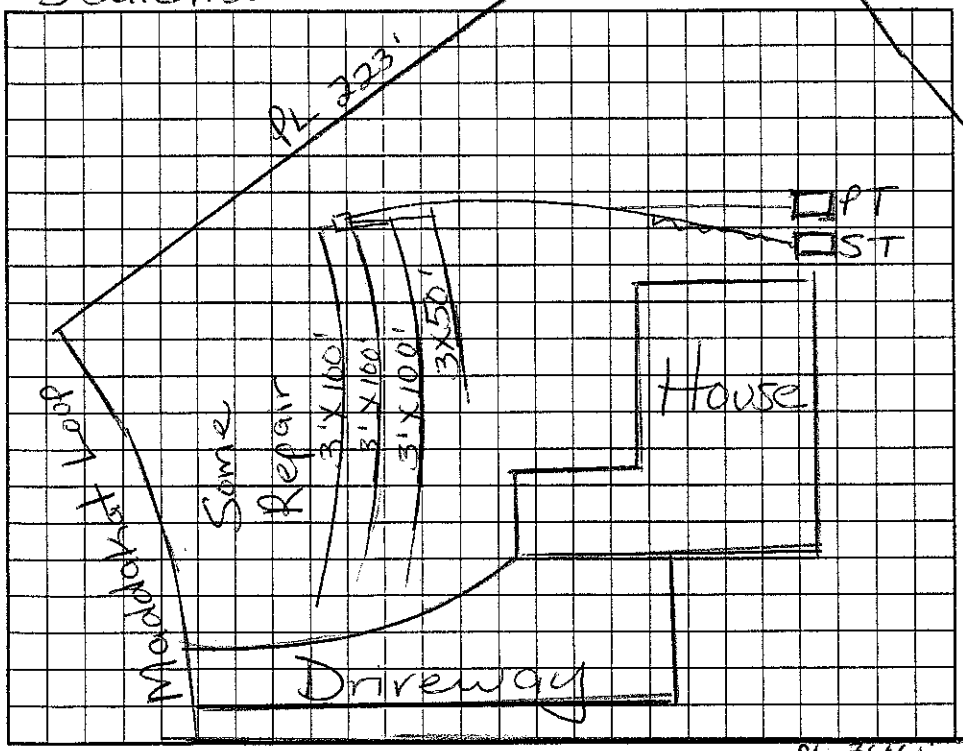

AS BUILT SKETCH

Finishing basement - Septic System originally sized for 5 Bedrooms. Total # of bedrooms when complete will still be 5

Originally installed 12/4/02 Copy attached.

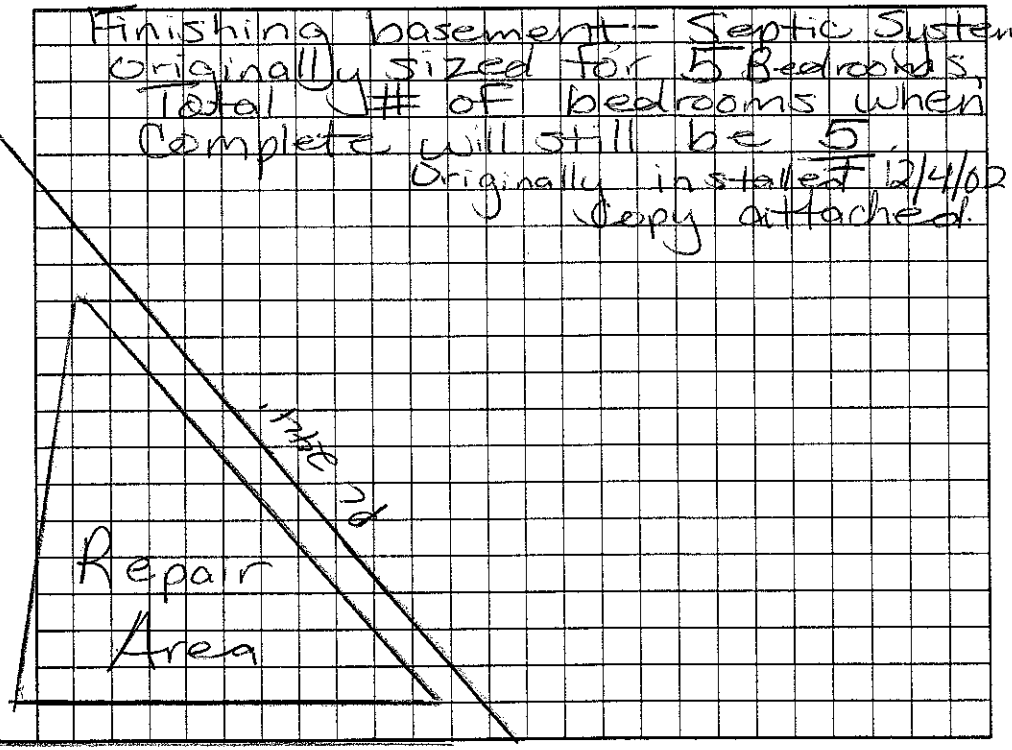

Permit can be suspended or revoked if any false information is supplied toward securing the permit/any unauthorized changes are made to the site/any unauthorized changes are made in the installation of the system. Improvement Permit with plat valid without expiration. Improvement Permit with site plan valid for sixty months. Authorization to Construct is valid for a period equal to that of Improvement Permit – not to exceed sixty months.

Signed: X date 1/27/03 Installed by:

Improvement Permit by: Maria H. Watson RS date 1/24/03 Operation Permit by: date

Authorization to Construct by: date Existing System Inspection by: Maria H. Watson RS date 1/24/03

HEALTH DEPT. COPY: WHITE OWNER COPY (FINAL): YELLOW OWNER COPY (INITIAL): PINK