...OUNTY HEALTH DEPARTMENT

STATESVILLE 704-878-5305 MOORESVILLE 704-664-5281

...ROVEMENT PERMIT / AUTHORIZATION TO CONSTRUCT / OPERATION PERMIT / EXISTING SYSTEM INSPEC

PERMIT# 81838 PIN# 462 594 1684 PT 4625799575 DATE 12/10/99

OWNER OR CONTRACTOR CRESCENT RESOURCES | Hughes, Homelink PHONE: Business 663-6905 T JACOBS Home

ADDRESS PO BOX 1003 CHARLOTTE NC 28202 & Zander

LOCATION BRAWLEY SCHOOL - TR MARSTON MILL - TR MADDAKAT ON RT 114 Maddaket Ln

SUBDIVISION POINT BLOCK / SECTION 4 LOT 356 LOT AREA 54551 SITE CLASS. PS DESIGN FLOW 480 GPD L.T.A.R. .2 gal/ft²

Septic Tank: 1000 + Gallons; STB 338 Date 10-9-03

Pump Tank: 900 + Gallons; PT 283 Date 10-12-03

Pump Make: Goulds? Model WE0312M0 Serial No. 6603

Nitrification Field: No Fields 1 Square Feet 1800 Linear Feet 600

No Lines 7 Trench Width 36" Max Trench Bottom Depth 36"

☑ New System ☐ Repair System Type: I, II, III, IV, V, VI

System Description: PUMP 25% REDUCTION

Repair System Description: PUMP ~~SAND~~ OFFSITE

Maintenance Agreement Required: ☐ Yes ☑ No PANEL

Gravel Depth n/a ☐ Slab ☑ Crawl Space ☐ Basement w/plumbing ☐ Basement wo/plumbing

☑ House/Mod. Home ☐ Mobile Home ☐ Business ☐ Other


No. Bedrooms 4 No. Bathrooms 4 No. Employees

Water Supply: ☐ Individual ☐ Public ☑ Community


Comments/Conditions: REMOVE ALL TERRACES AND BERMS
Reviewed Building plans 4/9/03, essentially in compliance with IP. House is deeper than House print on IP. so tanks will have to be moved back.

Comments:/Conditions: Note: Exercise Room meets qualifications of Bedroom
Checked lines 10/3/03

INITIAL SITE SKETCH 1"=50'

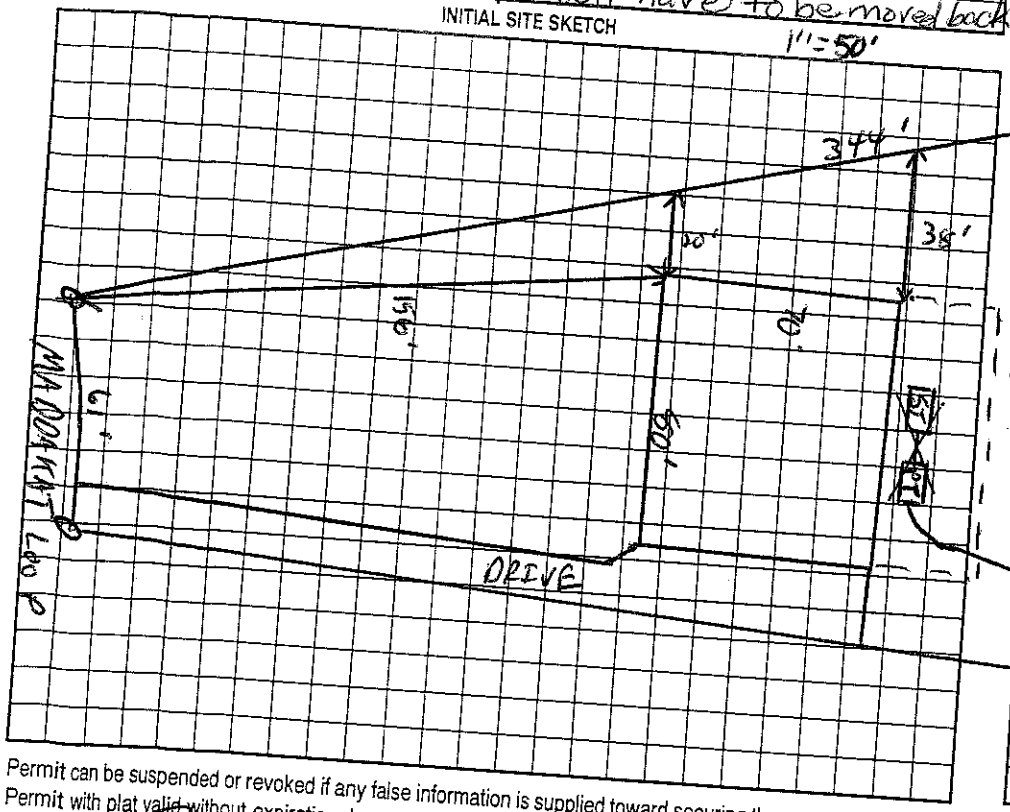

AS BUILT SKETCH

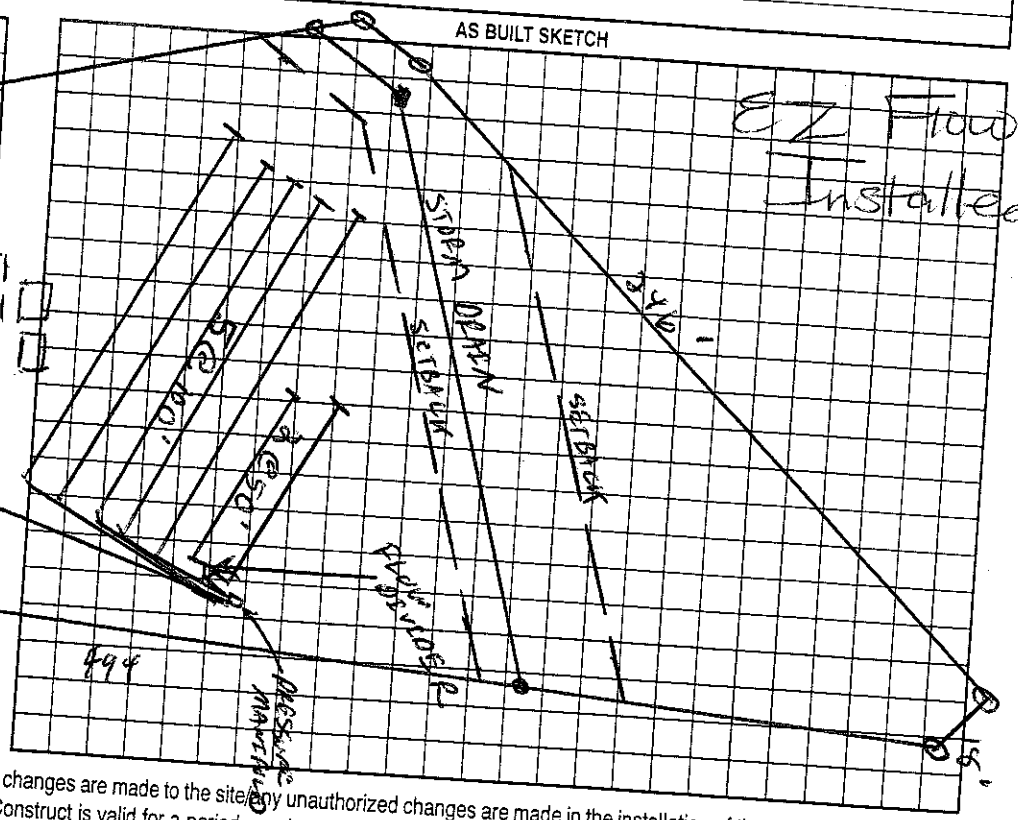

Permit can be suspended or revoked if any false information is supplied toward securing the permit/any unauthorized changes are made to the site/any unauthorized changes are made in the installation of the system. Improvement Permit with plat valid without expiration. Improvement Permit with site plan valid for sixty months. Authorization to Construct is valid for a period equal to that of Improvement Permit – not to exceed sixty months.

Signed: Paul C. Pennington

Improvement Permit by: C. Paul Pennington RS date 1-21-99

Authorization to Construct by: Marion H. Dotson RS date 12/10/99

Installed by: Bobby Mayhew

Operation Permit by: Marion H. Dotson RS date 4/9/03

Existing System Inspection by: Marion H. Dotson RS date 12/3/03

HEALTH DEPT. COPY: WHITE OWNER COPY (FINAL): YELLOW OWNER COPY (INITIAL): PINK