IREDELL COUNTY HEALTH DEPARTMENT

Authorization to Construct (3,45)

STATESVILLE 704-878-5305 MOORESVILLE 704-664-5281

IMPROVEMENT PERMIT / ~~CERTIFICATE OF COMPLETION~~ / OPERATION PERMIT / EXISTING SYSTEM INSPECTION

PROPERTY DESCRIPTION NO. 2105B DATE Mar 30 '95 (ROBERT HARE) TAX MAP NO. part of 2CA3 4625 80 0783 Watershed: ☑ Yes ☐ No

OWNER OR CONTRACTOR Crescent Resources Inc PHONE: Business / Home WS-IV

ADDRESS PO Box 1003 Charlotte

LOCATION Browley Fork Rd TR Yacht Rd TR Victoria Lane 4th lot on Right

SUBDIVISION Yacht Shores BLOCK / SECTION II LOT 19 LOT AREA 1.07 ac SITE CLASS Bpu156 DESIGN FLOW 480 gpd L.T.A.R. .3

Septic Tank: 1000 Gallons; STB 704 Date 10/15/95

Pump Tank: 1000 Gallons; PT 27 Date 11/3/95

Pump Make: MYERS Model SHG50 Serial No. 3 ~~00 HRS~~

Nitrification Field: ~~No~~ Fields 1 Square Feet ~~720~~ Linear Feet 400

~~No~~ Lines ~~4~~ Trench Width 36" Max Trench Bottom Depth 36" Gravel Depth N/A

☑ New System ☐ Repair System Type: I, II, III, IV, V, VI

System Description: pumped/pressure Infiltrator

Repair System Description: Same

Maintenance Agreement Required: ☐ Yes ☑ No

☑ House/Mod. Home No. Bedrooms ~~4~~ 3

☐ Mobile Home ~~No.~~ Bathrooms ~~3~~ 2½

☐ Business No. Employees

☐ Other

☐ Slab ☑ Crawl Space ☑ Basement w/plumbing ☐ Basement wo/plumbing

Water Supply: ☑ Individual ☐ Community ☐ Public

Comments: Pre construction conference w/ installer required prior to any installation work.


X Authorized changes to 3 Bedroom. Hrs

Comments: ~~DEVELOPMENT PERMIT~~ Authorization to Construct


Lines, Pressure, tanks checked - CBF

(.4 HP) 1" = 50'

INITIAL SITE SKETCH

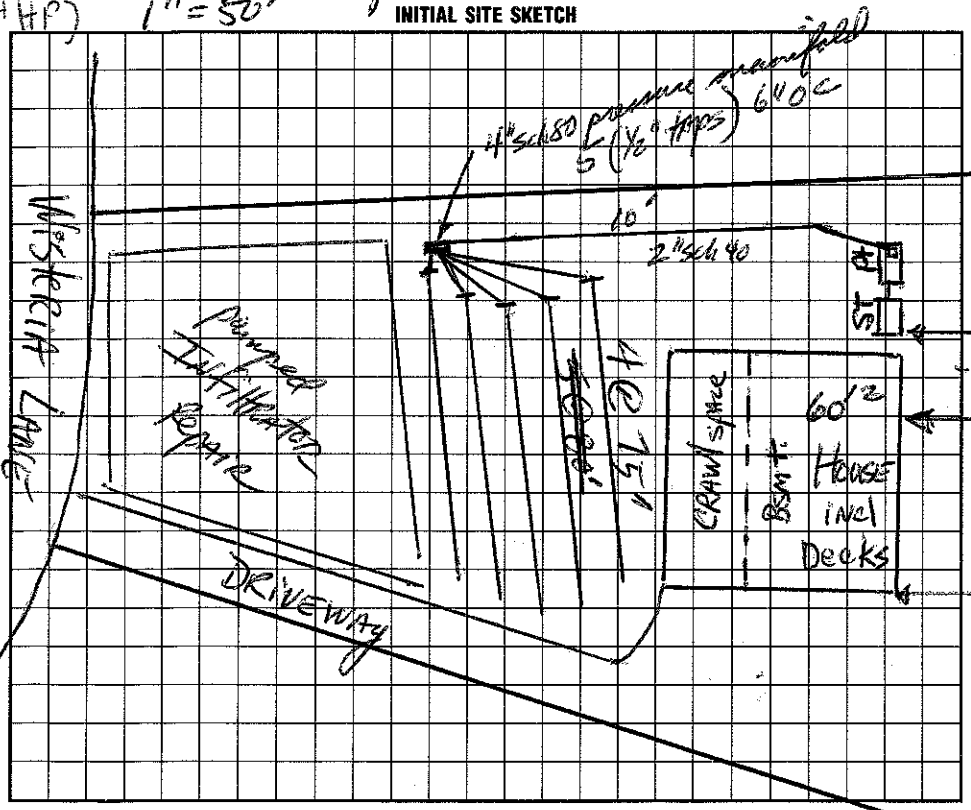

AS BUILT SKETCH

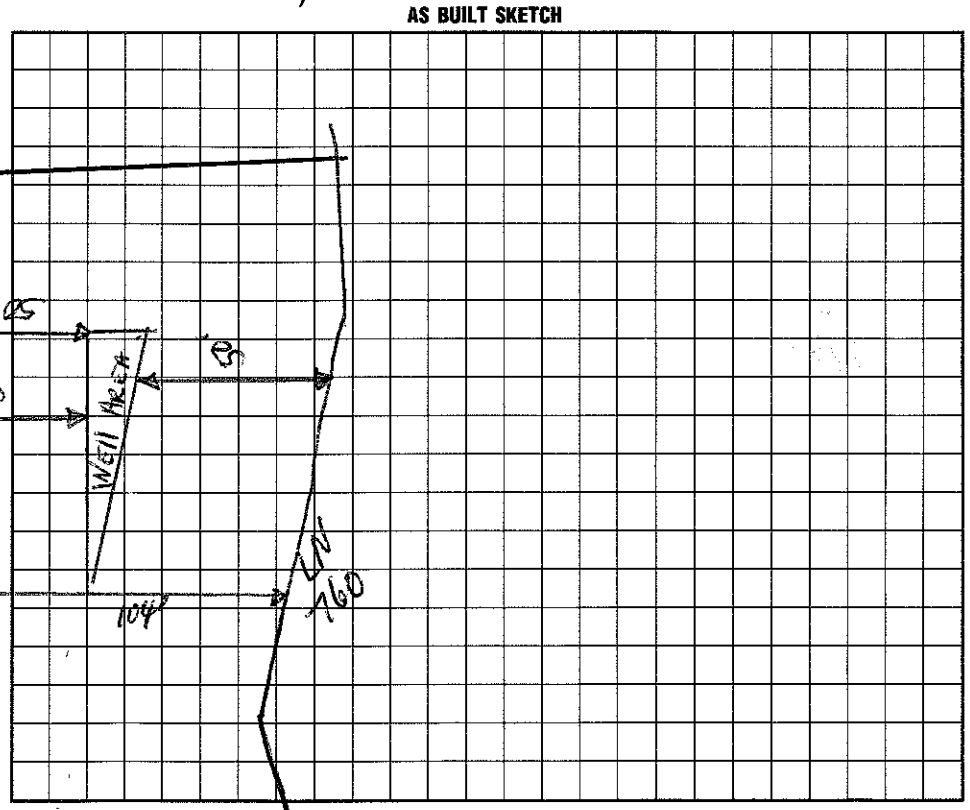

I understand that this permit can be suspended or revoked if any false information is supplied toward securing the permit/any unauthorized changes are made to the site/any unauthorized changes are made in the installation of the system. Improvement Permit is valid for 60 months from date of issuance.

Signed: X Paul G [illegible]

Installed by: LARRY BEAM

Improvement Permit by: [illegible] RS date

Certificate of Completion by: date

Existing System Inspection by: Authorized to Construct: Wesley Sparks RS date 3/14/96

Operation Permit by: C. [illegible] date 3/[illegible]

HEALTH DEPT. COPY: WHITE INSPECTION COPY (FINAL): GREEN OWNER COPY (FINAL): YELLOW INSPECTION COPY (INITIAL): PINK OWNER COPY (INITIAL): GOLD