IREDELL COUNTY HEALTH DEPARTMENT

STATESVILLE 704-878-5305 MOORESVILLE 704-664-5281

IMPROVEMENT PERMIT / CERTIFICATE OF COMPLETION / OPERATION PERMIT / EXISTING SYSTEM INSPECTION

PROPERTY DESCRIPTION NO. 21057 DATE May 26, '95 TAX MAP NO. part of 2CA3 4625801427 Watershed: ☑ Yes ☐ No

OWNER OR CONTRACTOR Crescent Resources, LLC PHONE: Business _____ Home 1154

ADDRESS PO Box 1003, Charlotte

LOCATION Brawley Sch Rd - TL Yacht Rd - TR Wisteria Lane at end on Right in cul-d-sac

SUBDIVISION Yacht Shores BLOCK / SECTION II LOT 17 LOT AREA 1.28 ac SITE CLASS. PS DESIGN FLOW ~~450~~ 360 gpd L.T.A.R. .3

Septic Tank: 1000 Gallons; STB 794 Date 10/16/95

Pump Tank: 1000 Gallons; PT 27 Date 10/8/95

Pump Make: Liberty Model LESIA Serial No. _____

Nitrification Field: No Fields 1 Square Feet 1200 Linear Feet ~~540~~ 400

No Lines 5@80' Trench Width 36" Max Trench Bottom Depth 36" Gravel Depth 12"

☑ New System ☐ Repair System Type: I, II, III, IV, V, VI

System Description: pumped conventional/pump

Repair System Description: same

Maintenance Agreement Required: ☐ Yes ☑ No

☑ House/Mod. Home No. Bedrooms ~~3~~ 2

☐ Mobile Home No. Bathrooms 2

☐ Business No. Employees _____

☐ Other _____

☐ Slab ☑ Crawl Space ☑ Basement w/plumbing ☐ Basement wo/plumbing


Water Supply: ☐ Individual ☑ Community ☐ Public

Comments:


Comments: ~~DEVELOPER~~ Ready to close 400 .16 ~~340~~ 340? .16 8" diameter 160/Dose

1" = 50'

INITIAL SITE SKETCH

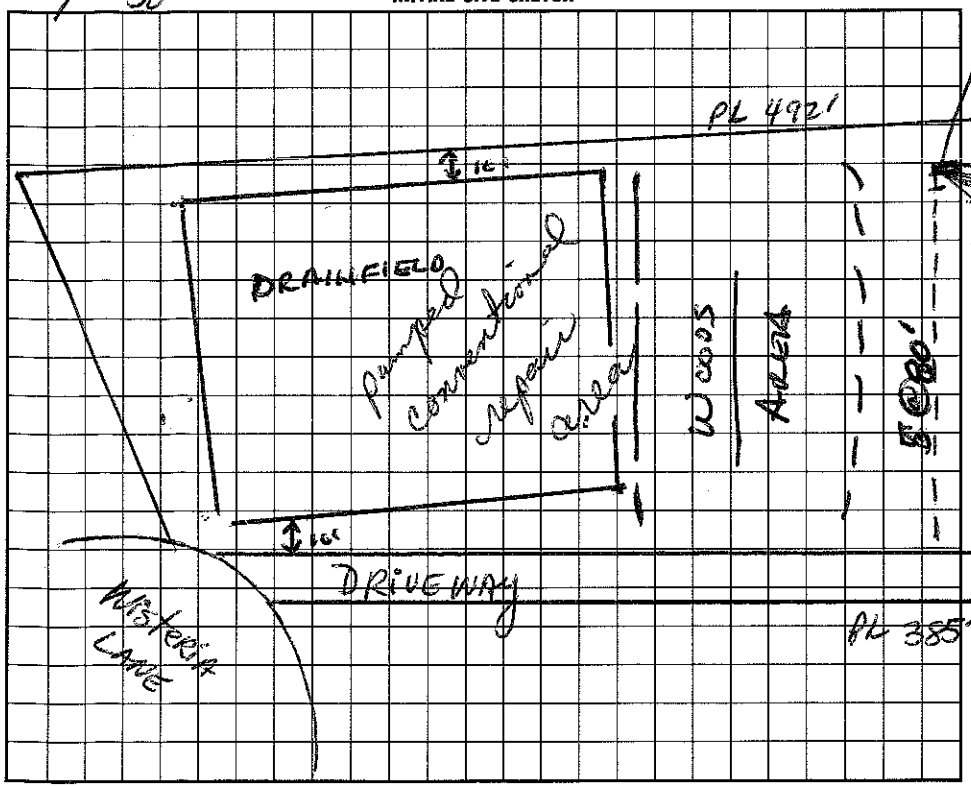

AS BUILT SKETCH

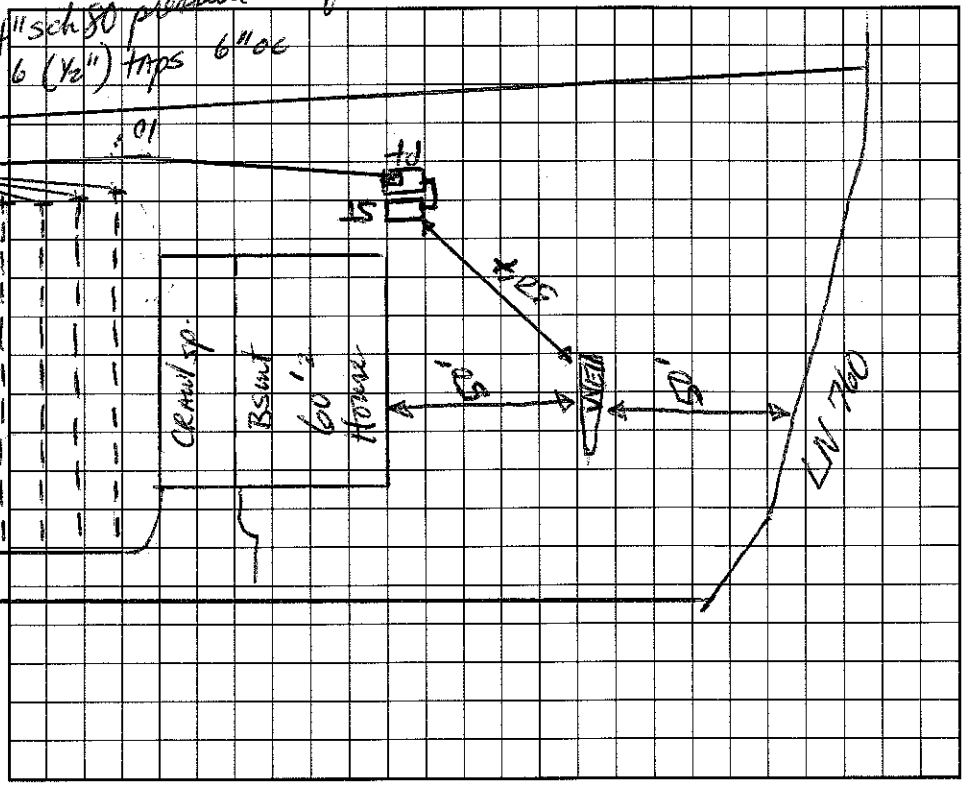

I understand that this permit can be suspended or revoked if any false information is supplied toward securing the permit/any unauthorized changes are made to the site/any unauthorized changes are made in the installation of the system. Improvement Permit is valid for 60 months from date of issuance.

Signed: X _____ 8/15/95

Improvement Permit by: Wesley Sparks RS date 5/26/95

Existing System Inspection by: _____ date _____

Installed by: Tim Runyon

Certificate of Completion by: Wesley Sparks RS date 12/8/95

Operation Permit by: Wesley Sparks RS date 12/8/95

HEALTH DEPT. COPY: WHITE INSPECTION COPY (FINAL): GREEN OWNER COPY (FINAL): YELLOW INSPECTION COPY (INITIAL): PINK OWNER COPY (INITIAL): GOLD