IREDELL COUNTY HEALTH DEPARTMENT

STATESVILLE 704-878-5305 MOORESVILLE 704-664-5281

IMPROVEMENT PERMIT / ~~CERTIFICATE OF COMPLETION~~ / OPERATION PERMIT / EXISTING SYSTEM INSPECTI

PROPERTY DESCRIPTION NO. 21054 DATE May 26 '95 TAX MAP NO. part of 2CA3 4625 80 1519 Watershed: ☑ Yes ☐ No

OWNER OR CONTRACTOR Crescent Resources clo/ INVALID BUILDERS PHONE: Business _____ Home 4054

ADDRESS PO Box 1003 Charlotte

LOCATION Brawley Sch Rd. TL Yacht Rd. TR Wisteria Lane on right in cul-d-sac

SUBDIVISION Yacht Shores BLOCK / SECTION II LOT 18 LOT AREA 1 Ac. SITE CLASS. PS DESIGN FLOW 450 gpd L.T.A.R. .3

Septic Tank: 1000 Gallons; STB 744 Date 4/6/97

Pump Tank: 1000 Gallons; PT 27 Date 5/16/97

Pump Make: HYDROMATIC Model .5 HP Serial No. _____

Nitrification Field: No Fields 1 Square Feet 1620 Linear Feet 540

No Lines 6@90' Trench Width 36" Max Trench Bottom Depth 36" Gravel Depth 12"

☑ New System ☐ Repair System Type: I, II, (III), IV, V, VI

System Description: pumped conventional/pr

Repair System Description: Sime or pump Inf.

Maintenance Agreement Required: ☐ Yes ☑ No

☑ House/Mod. Home No. Bedrooms 4/4

☐ Mobile Home No. Bathrooms 4/4

☐ Business No. Employees ____

☐ Other _____

☐ Slab ☑ Crawl Space ☑ Basement w/plumbing ☐ Basement wo/plumbing

Water Supply:
☐ Individual
☑ Community
☐ Public

Comments:


Comments: ~~DEVELOPER~~ Authorization to Construct

~~PERMIT~~ TRANSFER


LINES, TANKS, PRESSURE checked 6/26/97

1"=50'

INITIAL SITE SKETCH

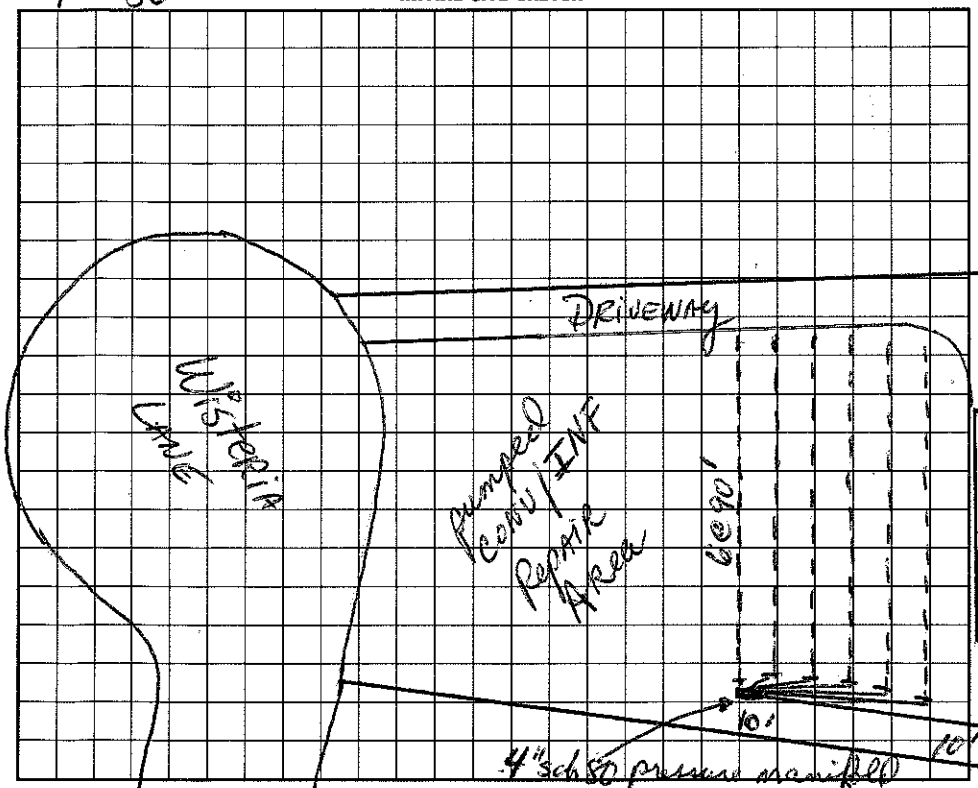

AS BUILT SKETCH

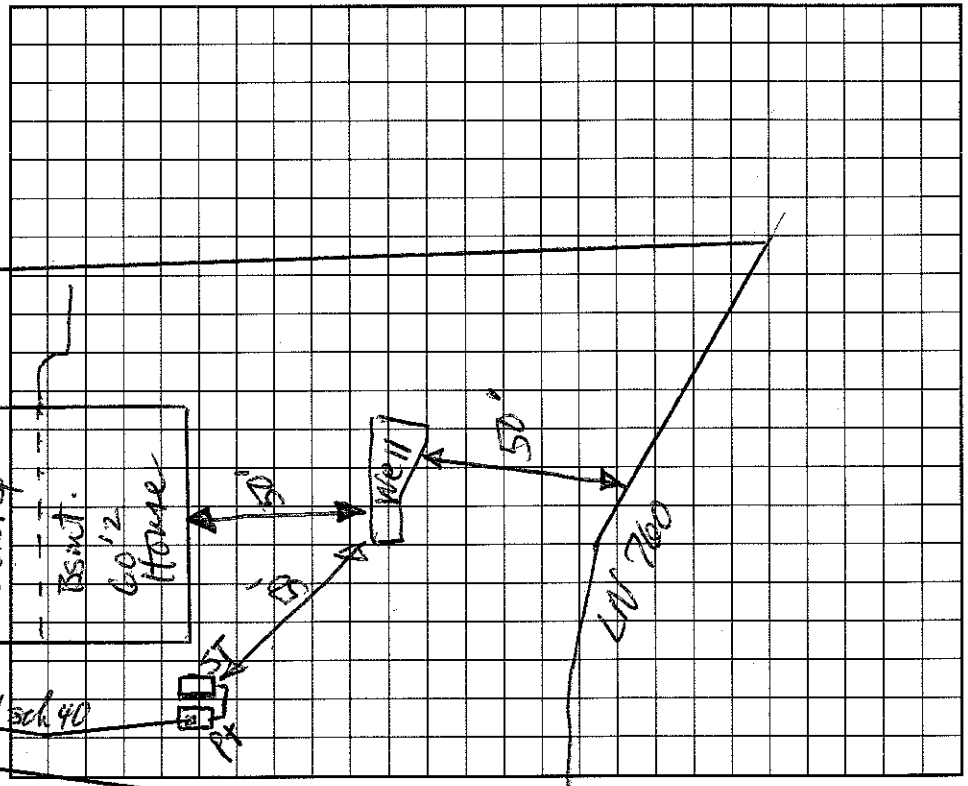

I understand that this permit can be suspended or revoked if any false information is supplied toward securing the permit/any unauthorized changes are made to the site/any unauthorized changes are made in the installation of the system. Improvement Permit is valid for 60 months from date of issuance.

Signed: [signature]

Improvement Permit by: [signature], RS date 5/26/95

Existing System Inspection by: [signature] RS. date 12/28/95

Installed by: J&M Ammons

Certificate of Completion by: _____ date _____

Operation Permit by: [signature] date 9/2/97

HEALTH DEPT. COPY: WHITE INSPECTION COPY (FINAL): GREEN OWNER COPY (FINAL): YELLOW INSPECTION COPY (INITIAL): PINK OWNER COPY (INITIAL): GOLD