932-7904

IREDELL COUNTY HEALTH DEPARTMENT

STATESVILLE 704-878-5305 MOORESVILLE 704-664-5281

IMPROVEMENT PERMIT / AUTHORIZATION TO CONSTRUCT / OPERATION PERMIT / EXISTING SYSTEM INSPECTION

PERMIT# 21053 PIN# pt of 2C13 4625 80 2342 DATE 1/21/99

OWNER OR CONTRACTOR DONALD SMITH PHONE: Business _____ Home _____

ADDRESS 159 FARMSTEAD LN MOORESVILLE NC 28117

LOCATION BRAWLEY SCHOOL - TL YACHT RD - TR BAY BREEZE - AT END

SUBDIVISION YACHT SHORES BLOCK / SECTION II LOT 13 LOT AREA 1.03 AC SITE CLASS. CS DESIGN FLOW 480 L.T.A.R. .30 MD/EF

Septic Tank: 1000 Gallons; STB 925 Date 9/11/99
Pump Tank: 1000 Gallons; PT 302 Date 9/10/99
Pump Make: ZOELLER Model N163F Serial No. 8/30/99
Nitrification Field: No Fields 1 Square Feet 1620 Linear Feet 540
No Lines 6@90' Trench Width 36" Max Trench Bottom Depth 36" Gravel Depth 12"

☑ New System ☐ Repair System Type: I, II, (III), IV, V, VI
System Description: PUMP CONVENTIONAL
Repair System Description: SAME
Maintenance Agreement Required: ☐ Yes ☐ No

☑ House/Mod. Home No. Bedrooms 4
☐ Mobile Home No. Bathrooms 4
☐ Business No. Employees ____
☐ Other ____


☐ Slab ☑ Crawl Space ☑ Basement w/plumbing ☐ Basement wo/plumbing

Water Supply: ☑ Individual ☐ Public ☐ Community


Comments:/Conditions:

Comments:/Conditions:
10/19 Pursuant set -

INITIAL SITE SKETCH 1" = 50'

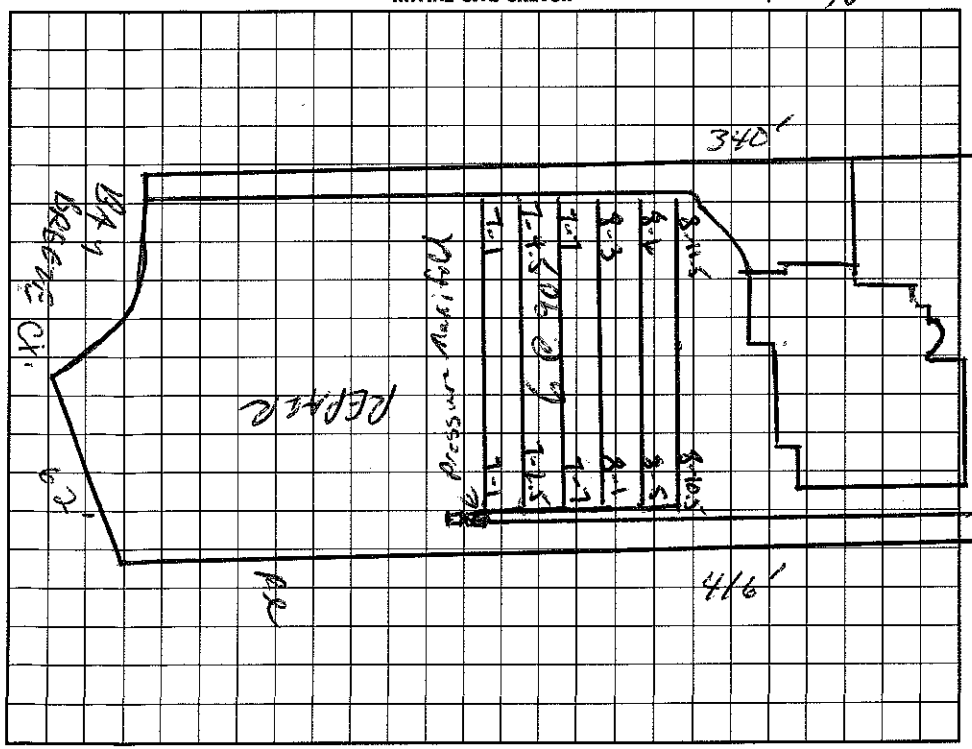

AS BUILT SKETCH

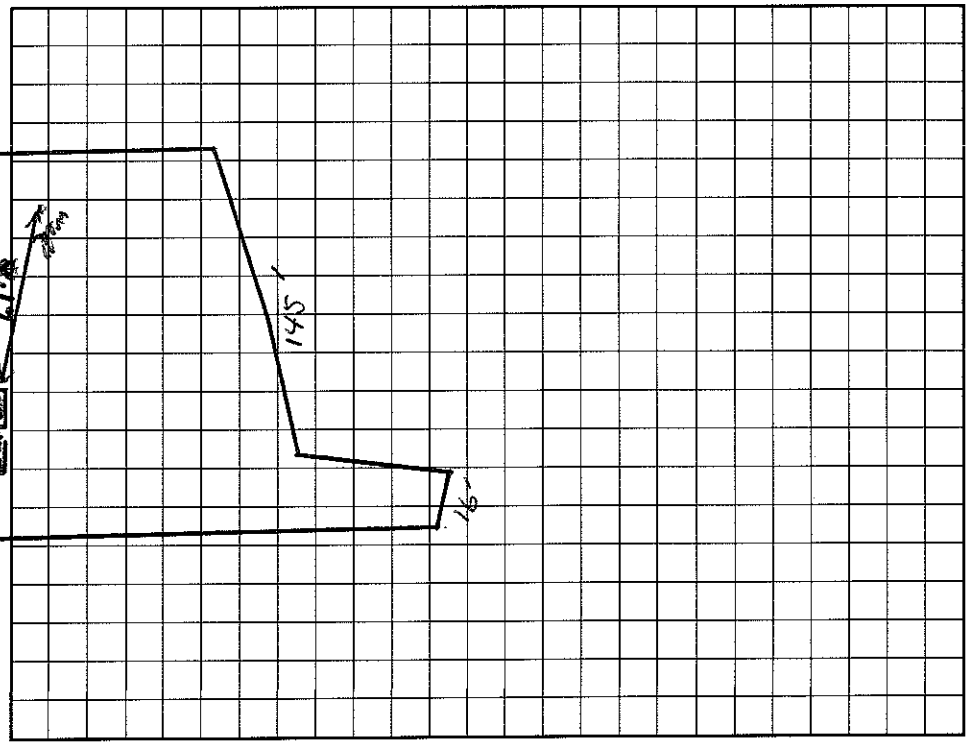

I understand that this permit can be suspended or revoked if any false information is supplied toward securing the permit/any unauthorized changes are made to the site/any unauthorized changes are made in the installation of the system. Improvement Permit with plat valid without expiration. Improvement Permit with site plan valid for sixty months. Authorization to Construct is valid for a period equal to that of Improvement Permit – not to exceed sixty months.

Signed: _____ date 10/1/99 Installed by: Delbert Beaton RS date 11/15/99

Improvement Permit by: C. _____ RS date 11/21/99 Operation Permit by: Maria H. Dotson

Authorization to Construct by: C. _____ RS date 11/4/99 Existing System Inspection by: Maria Dotson date 11/15/99

HEALTH DEPT. COPY: WHITE INSPECTION COPY (FINAL): GREEN OWNER COPY (FINAL): YELLOW INSPECTION COPY (INITIAL): PINK OWNER COPY (INITIAL): GOLD