IREDELL COUNTY HEALTH DEPARTMENT

STATESVILLE 704-878-5305 MOORESVILLE 704-664-5281

IMPROVEMENT PERMIT / AUTHORIZATION TO CONSTRUCT / OPERATION PERMIT / EXISTING SYSTEM INSPE

PERMIT# 21060 PIN# part of 2CA3 4625 80 2972 DATE ~~1st~~ 5/18/99

OWNER OR CONTRACTOR Carl Peggs PHONE: Business 895-7810 Home

ADDRESS 116 Ashford Hollow LN, Mooresville NC

LOCATION Brawley Sch Rd TL Yacht Rd. TR Wisteria LN 2nd lot on Right

SUBDIVISION Yacht Shores BLOCK / SECTION II LOT 21 LOT AREA .74AC SITE CLASS. PS DESIGN FLOW 480 L.T.A.R. .3

Septic Tank: 1000 Gallons; STB 825 Date 4-2-99
Pump Tank: Gallons; PT Date
Pump Make: Model Serial No.
Nitrification Field: No Fields 1 Square Feet 1200 Linear Feet 400
No Lines 5@60' Trench Width 36" Max Trench Bottom Depth 36" Gravel Depth N/A

☒ New System ☐ Repair System Type: I, II, (III), IV, V, VI
System Description: Gravity 25% Red
Repair System Description: Chamber/Panel
Maintenance Agreement Required: ☐ Yes ☐ No


☒ House/Mod. Home No. Bedrooms 4
☐ Mobile Home No. Bathrooms 4
☐ Business No. Employees
☐ Other
☐ Slab ☒ Crawl Space ☐ Basement w/plumbing ☐ Basement wo/plumbing

Water Supply: ~~☐~~ Individual ☐ Public ☐ Community


Comments:/Conditions:

Comments:/Conditions:

INITIAL SITE SKETCH

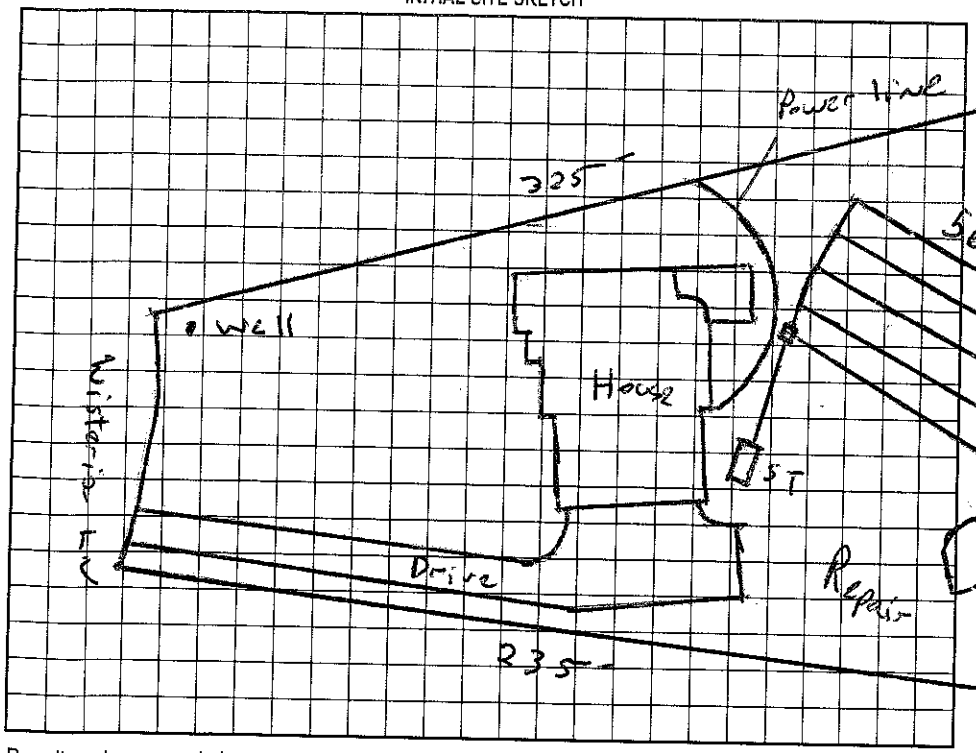

AS BUILT SKETCH

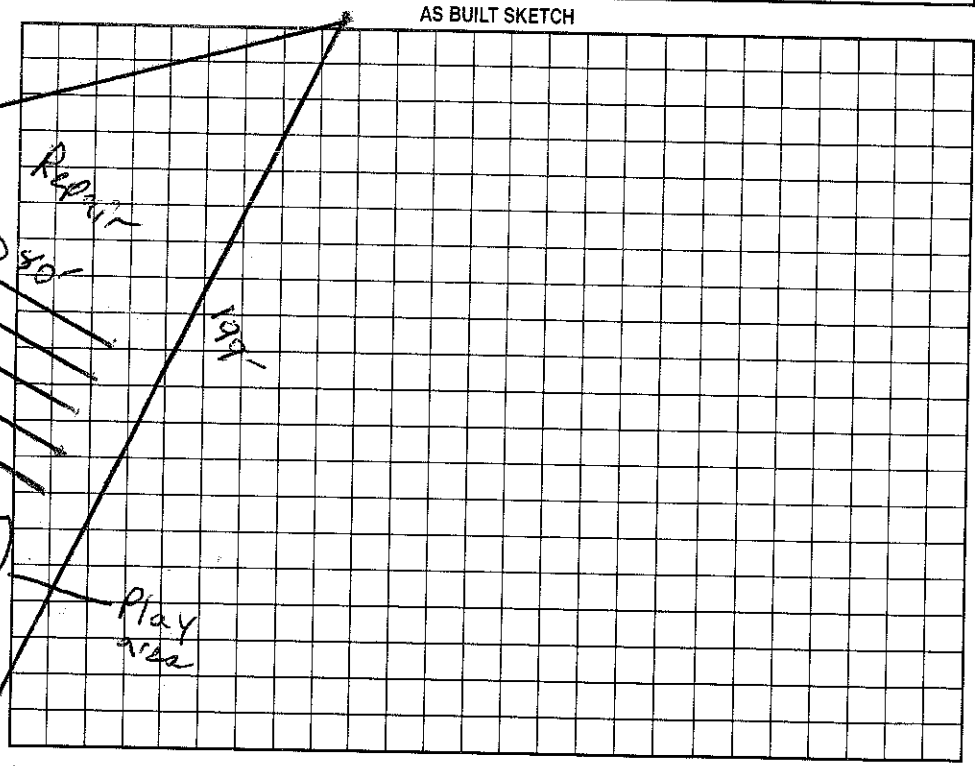

Permit can be suspended or revoked if any false information is supplied toward securing the permit/any unauthorized changes are made to the site/any unauthorized changes are made in the installation of the system. Improvement Permit with plat valid without expiration. Improvement Permit with site plan valid for sixty months. Authorization to Construct is valid for a period equal to that of Improvement Permit – not to exceed sixty months.

Signed: date 5/19/99 Installed by: Boston, Delbert

Improvement Permit by: Jeff Morgan date 5/19/99 Operation Permit by: Jeff Morgan date 6-23-99

Authorization to Construct by: Jeff Morgan date 5/19/99 Existing System Inspection by: date

HEALTH DEPT. COPY: WHITE OWNER COPY (FINAL): YELLOW OWNER COPY (INITIAL): PINK