IREDELL COUNTY HEALTH DEPARTMENT

STATESVILLE 704-878-5305 MOORESVILLE 704-664-5281

IMPROVEMENT PERMIT / AUTHORIZATION TO CONSTRUCT / OPERATION PERMIT / EXISTING SYSTEM INSPECTION

PERMIT# 21051 PIN# Pt of 2c A3 4625 80 3028 DATE 7/22/98

OWNER OR CONTRACTOR Allen R. Johnston PHONE: Business 364-0421 Home

ADDRESS 6720 Cascade Rd. Charlotte, NC. 28211

LOCATION Brawley School Rd, TL Yacht Rd. TR BAYBREEZE CT. on (L) off cul de sac

SUBDIVISION Yacht Shores BLOCK / SECTION TT LOT 11 LOT AREA ~ 1.17 Ac SITE CLASS: PS DESIGN FLOW 480 L.T.A.R. .35

Septic Tank: 1000 Gallons; STB 1012 Date 4-31-00

Pump Tank: 1000 Gallons; PT 11 Date 2-29-00

Pump Make: Myers Model ME.40 Serial No.

Nitrification Field: No. Fields 1 Square Feet 1440 Linear Feet 480

No Lines 6 Trench Width 36" Max Trench Bottom Depth 36" Gravel Depth 12"

[X] New System [ ] Repair System Type: I, II, (III) IV, V, VI

System Description: Pres Man to Conventional

Repair System Description: Same

Maintenance Agreement Required: [ ] Yes [X] No

[X] House/Mod. Home No. Bedrooms 4

[ ] Mobile Home No. Bathrooms 3.5

[ ] Business No. Employees

[ ] Other


[ ] Slab [X] Crawl Space [ ] Basement w/plumbing [ ] Basement wo/plumbing

Water Supply: [X] Individual [ ] Public [ ] Community


Comments:/Conditions:

Comments:/Conditions: Tanks, lines & pressure tested 8/1/2000 ★ Need ALL screws on Nemalk box, need to chalk where wires come into box. MD

INITIAL SITE SKETCH

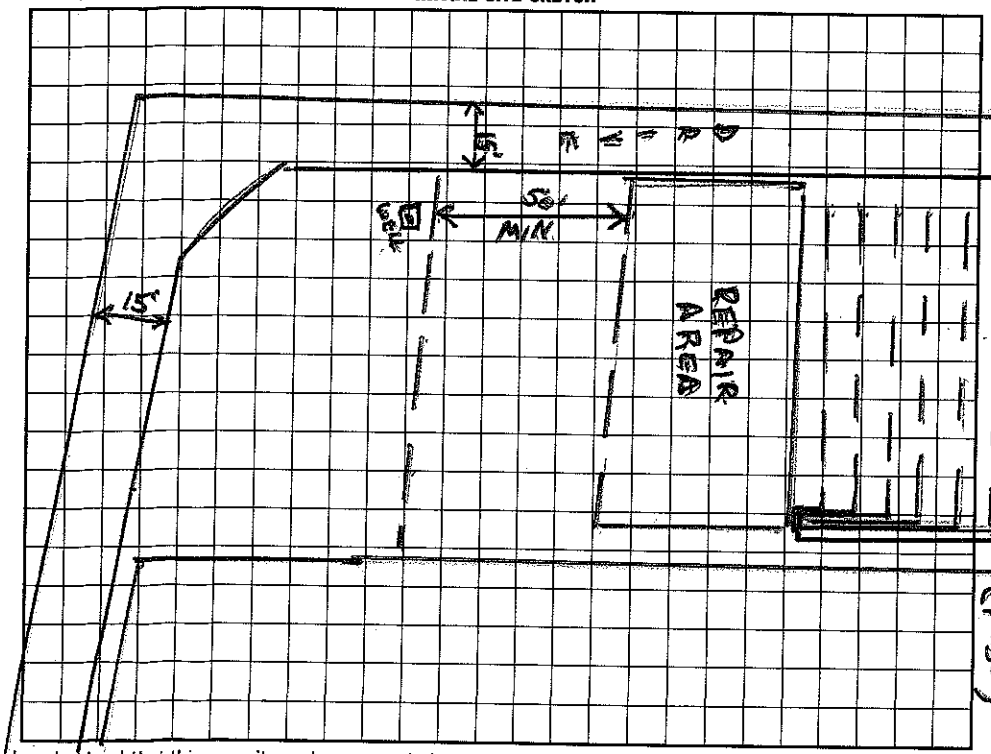

AS BUILT SKETCH

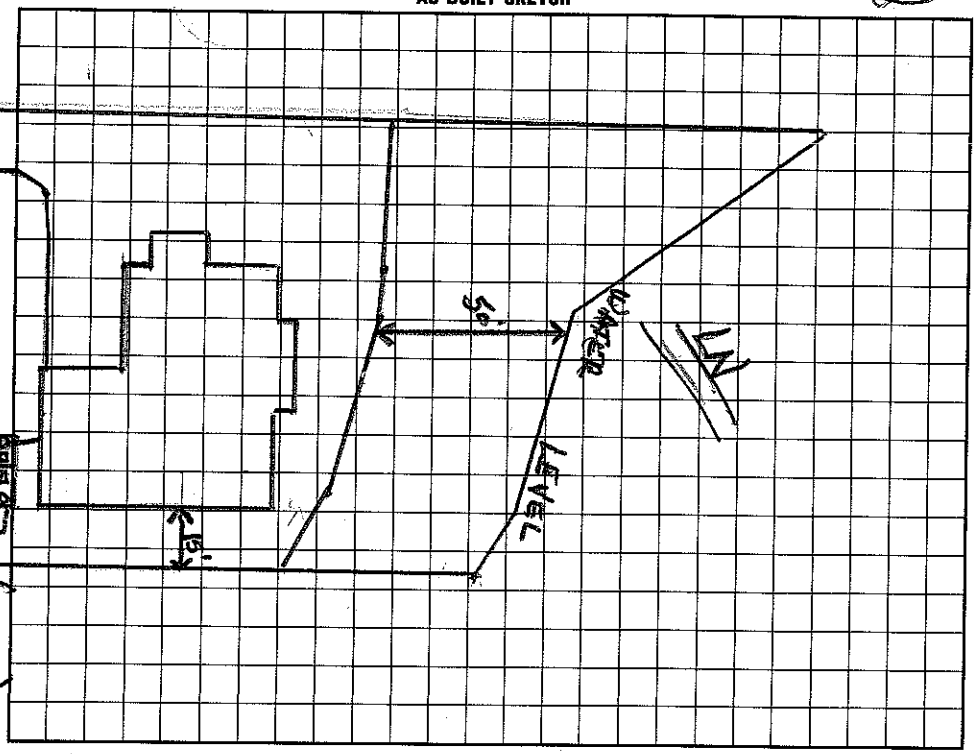

I understand that this permit can be suspended or revoked if any false information is supplied toward securing the permit/any unauthorized changes are made to the site/any unauthorized changes are made in the installation of the system. Improvement Permit with plat valid without expiration. Improvement Permit with site plan valid for sixty months. Authorization to Construct is valid for a period equal to that of Improvement Permit – not to exceed sixty months.

Signed: ★ Clay Cooper date 7/31/98

Improvement Permit by: Wesley Sparks R.S. date 7/27/98

Authorization to Construct by: Wesley Sparks R.S. date 7/27/98

Installed by: Richard Abernathy

Operation Permit by: Maria W. Davis date 11/17/2000

Existing System Inspection by: date

HEALTH DEPT. COPY: WHITE INSPECTION COPY (FINAL): GREEN OWNER COPY (FINAL): YELLOW INSPECTION COPY (INITIAL): PINK OWNER COPY (INITIAL): GOLD