IREDELL COUNTY HEALTH DEPARTMENT

STATESVILLE 704-878-5305 — MOORESVILLE 704-664-5281

IMPROVEMENT PERMIT / CERTIFICATE OF COMPLETION / OPERATION PERMIT / EXISTING SYSTEM INSPECTION

4625 80 4636

PROPERTY DESCRIPTION NO. 21056 DATE May 31 '95 TAX MAP NO. part of 2CA3

OWNER OR CONTRACTOR Crescent Resources Inc PHONE: Business _____ Home _____ Watershed: ☑ Yes ☐ No

ADDRESS PO Box 4003 Charlotte

LOCATION Brawley Sch Rd. to Yacht Rd. to Waterfall Lane 1st lot on left WS-IV

SUBDIVISION Yacht Shores BLOCK / SECTION II LOT 16 LOT AREA .79AC SITE CLASS. 5 Sprinkle DESIGN FLOW 180gpd L.T.A.R. .03

Septic Tank: 1000 Gallons; STB 625 Date 10/5/95

Pump Tank: _____ Gallons; PT _____ Date _____

Pump Make: _____ Model _____ Serial No. _____

Nitrification Field: No Fields 1 Square Feet 1200 Linear Feet 400

No Lines 4 Trench Width 36" Max Trench Bottom Depth 36" Gravel Depth N/A

☑ New System ☐ Repair System Type: I, II, III, IV, V, VI

System Description: Quantity 1000 Heritage

Repair System Description: Rainwell 625 PBTS

Maintenance Agreement Required: ☐ Yes ☑ No

☑ House/Mod. Home No. Bedrooms 4

☐ Mobile Home No. Bathrooms 4

☐ Business No. Employees ____

☐ Other _____

☐ Slab ☑ Crawl Space ☐ Basement w/plumbing ☐ Basement wo/plumbing


Water Supply: ☑ Individual ☐ Community ☐ Public

Comments:


Comments: ~~DEVELOPER~~ ~~PERMIT~~ READY TO ISSUE AWS 9/19/95

1"=50'

INITIAL SITE SKETCH

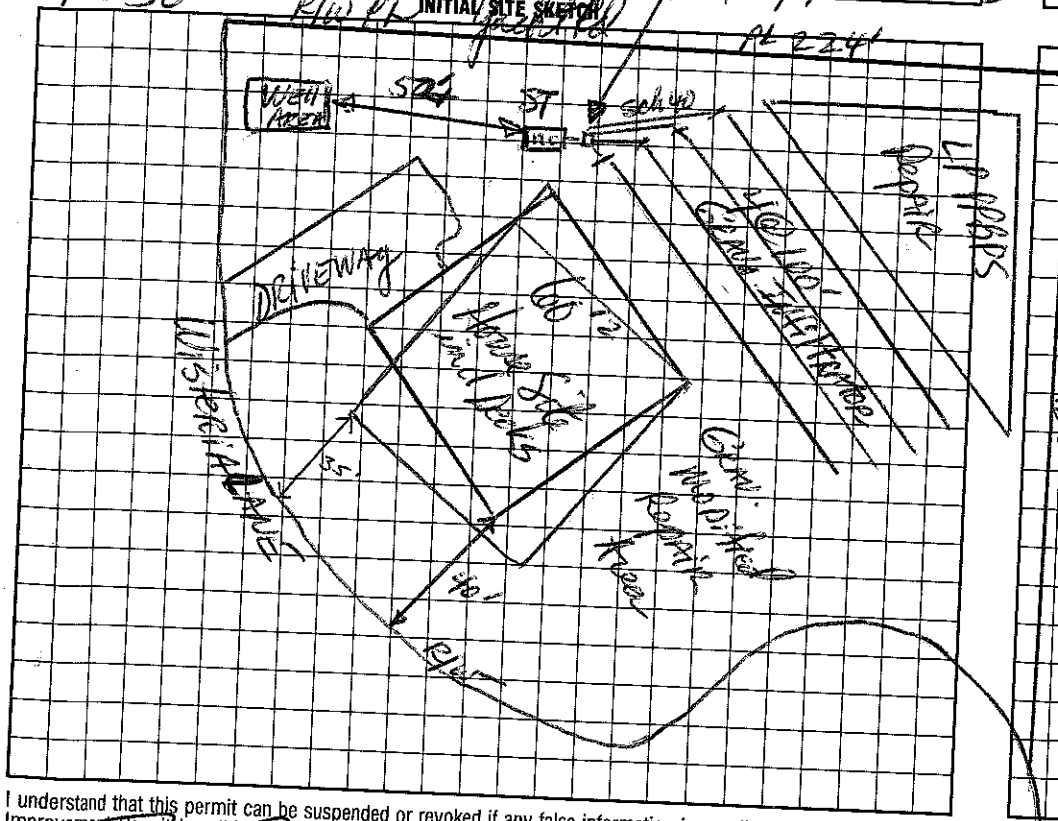

AS BUILT SKETCH

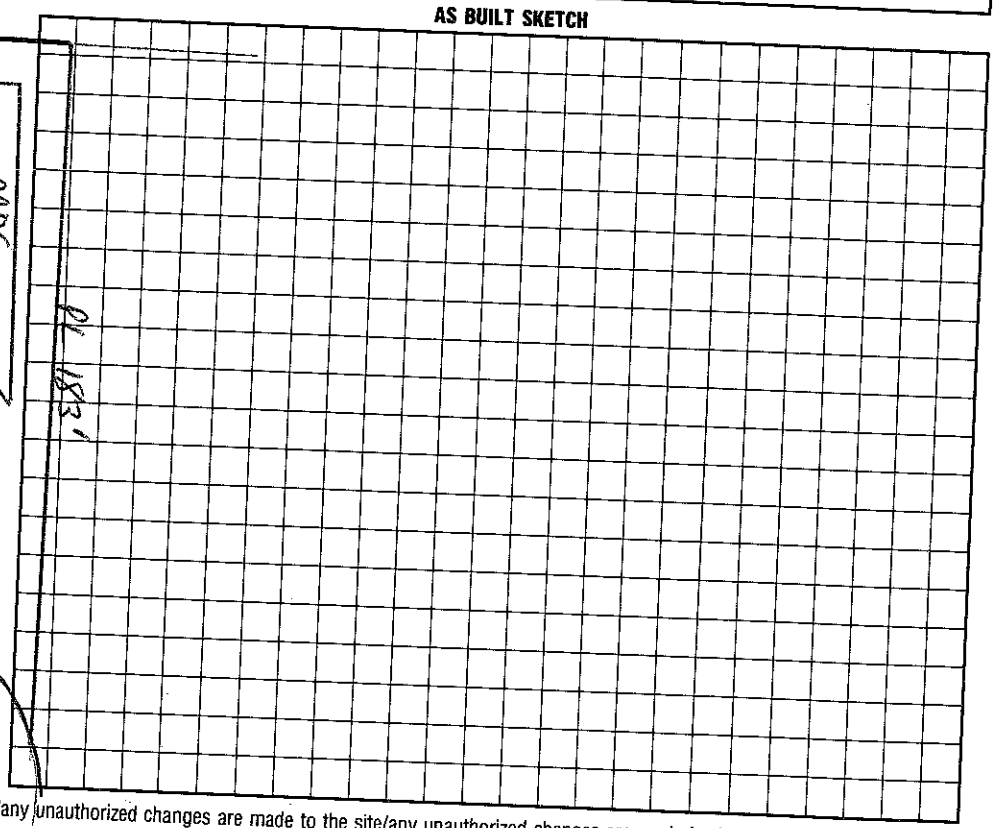

I understand that this permit can be suspended or revoked if any false information is supplied toward securing the permit/any unauthorized changes are made to the site/any unauthorized changes are made in the installation of the system. Improvement Permit is valid for 60 months from date of issuance.

Signed: _____

Improvement Permit by: Jesse Robinson, REHS Wesley Sparkes 9/19/95 date 5/31/95

Existing System Inspection by: _____ date _____

Installed by: Tim Ammons

Certificate of Completion by: _____ date _____

Operation Permit by: Wesley Sparkes RS date 12/13/95

HEALTH DEPT. COPY: WHITE — INSPECTION COPY (FINAL): GREEN — OWNER COPY (FINAL): YELLOW — INSPECTION COPY (INITIAL): PINK — OWNER COPY (INITIAL): GOLD