IREDELL COUNTY HEALTH DEPARTMENT

→ AUTHORIZATION TO CONSTRUCT 4625804905

STATESVILLE 704-878-5305 MOORESVILLE 704-664-5281

IMPROVEMENT PERMIT / ~~CERTIFICATE OF COMPLETION~~ / OPERATION PERMIT / EXISTING SYSTEM INSPECTION

PROPERTY DESCRIPTION NO. 21061 DATE 1/7/97 TAX MAP NO. pt of 2CA3

OWNER OR CONTRACTOR CRESCENT RESOURCES INC PHONE: Business Home Watershed: ☑ Yes ☐ No

ADDRESS PO BOX 1003, CHARLOTTE NC

LOCATION BRANLEY SCHOOL RD - TL YACHT RD - TR WISTERIA - CORNER LOT

SUBDIVISION YACHT SHORES BLOCK / SECTION II LOT 22 LOT AREA .54 AC SITE CLASS. PS DESIGN FLOW 360 GPD L.T.A.R. .35

Septic Tank: 1000 Gallons; STB 744 Date 12/11/97

Pump Tank: Gallons; PT Date

Pump Make: Model Serial No.

Nitrification Field: No Fields 2 Square Feet 1080 Linear Feet 360

No Lines 6 @ 60' Trench Width 36" Max Trench Bottom Depth 36" Gravel Depth 12"

☑ New System ☐ Repair System Type: I, II, III, IV, V, VI

System Description: GRAVITY CONVENTIONAL

Repair System Description: 1"/LP PPBPS

Maintenance Agreement Required: ☐ Yes ☑ No

☑ House/Mod. Home No. Bedrooms 3

☐ Mobile Home No. Bathrooms 3

☐ Business No. Employees

☐ Other

☐ Slab ☑ Crawl Space ☐ Basement w/plumbing ☐ Basement wo/plumbing

Water Supply: ☑ Individual ☐ Community ☐ Public

Comments:

This permit replaces permit issued 5/30/95 by DRH


72

360

Comments:

INITIAL SITE SKETCH

1"=50'

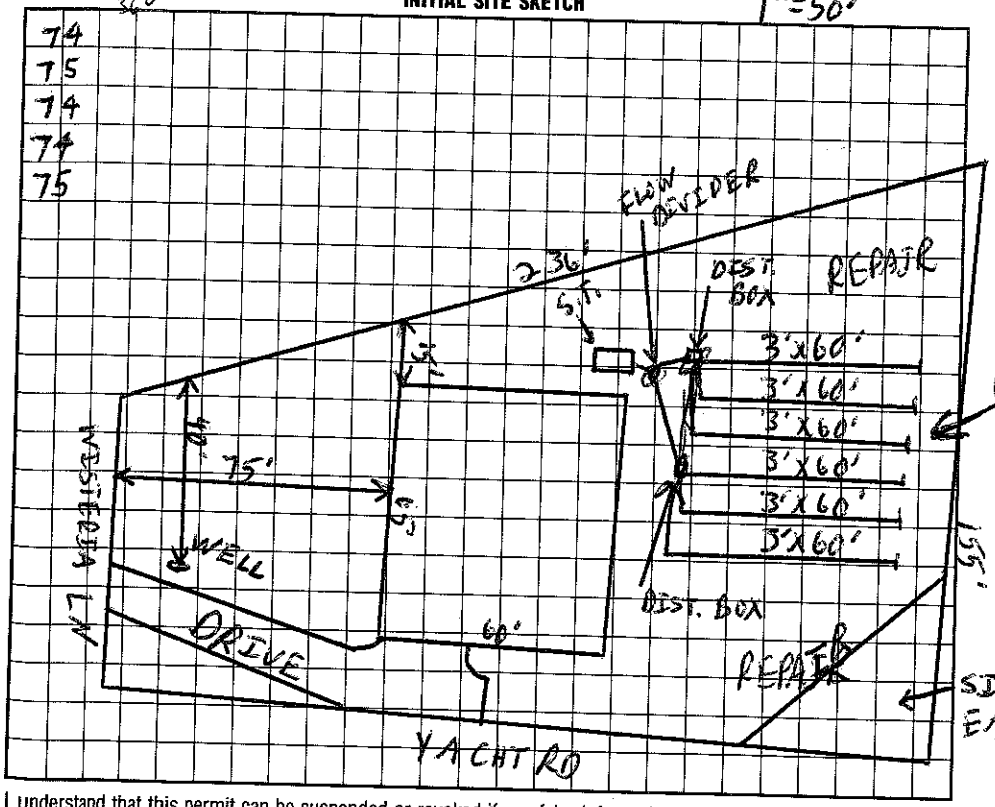

AS BUILT SKETCH

I understand that this permit can be suspended or revoked if any false information is supplied toward securing the permit/any unauthorized changes are made to the site/any unauthorized changes are made in the installation of the system. Improvement Permit is valid for 60 months from date of issuance.

Signed: Michael J Mattie / Lyle Brothers Partnership

Improvement Permit by: C. [signature] EHSE date 1/7/97

AUTHORIZATION TO CONSTRUCT Existing System Inspection by: C. [signature] 12/11/97

Installed by: ABBEY

Certificate of Completion by: date

Operation Permit by: C. [signature] RS date 4/29/98

HEALTH DEPT. COPY: WHITE INSPECTION COPY (FINAL): GREEN OWNER COPY (FINAL): YELLOW INSPECTION COPY (INITIAL): PINK OWNER COPY (INITIAL): GOLD