IREDELL COUNTY HEALTH DEPARTMENT

STATESVILLE 704-878-5305 4625 80 7084 MOORESVILLE 704-664-5281

IMPROVEMENT PERMIT / CERTIFICATE OF COMPLETION / OPERATION PERMIT / EXISTING SYSTEM INSPECTION

PROPERTY DESCRIPTION NO. 17329 DATE October 26, '93 TAX MAP NO. 2C2A3 Watershed: ☑ Yes ☐ No

OWNER OR CONTRACTOR R & L MacLeod PHONE: Business (704) 483-3580 Home L.N.

ADDRESS 428 Lakeshore Rd. N. Denver, N.C.

LOCATION 1100 TL 1101 (Yacht Rd.) ¼ mile on left

SUBDIVISION Yacht Cove BLOCK / SECTION LOT 3 LOT AREA 63' x 147' SITE CLASS. PS DESIGN FLOW 360gpd L.T.A.R. .03

Septic Tank: 1000 Gallons; STB DEL 794 Date 11-26-93

Pump Tank: Gallons; PT Date

Pump Make: Model Serial No.

Nitrification Field: No Fields 2 Square Feet 1200 Linear Feet 400

No Lines 6 Trench Width 36" Max Trench Bottom Depth 36" Gravel Depth

☑ New System ☐ Repair System Type: I (II) III, IV, V, VI

System Description: gravity conventional

Repair System Description: same

Maintenance Agreement Required: ☐ Yes ☑ No

☑ House/Mod. Home No. Bedrooms 3

☐ Mobile Home No. Bathrooms 2

☐ Business No. Employees

☐ Other


☐ Slab ☑ Crawl Space ☐ Basement w/plumbing ☐ Basement wo/plumbing

Water Supply: ☑ Individual ☐ Community ☐ Public


Comments: Follow contour; install 200' off each subfold.

Comments: AREA DESIGNATED "REPAIR" USED FOR ORIGINAL INSTALLATION - BACK YARD DESIGNATED REPAIR.

INITIAL SITE SKETCH

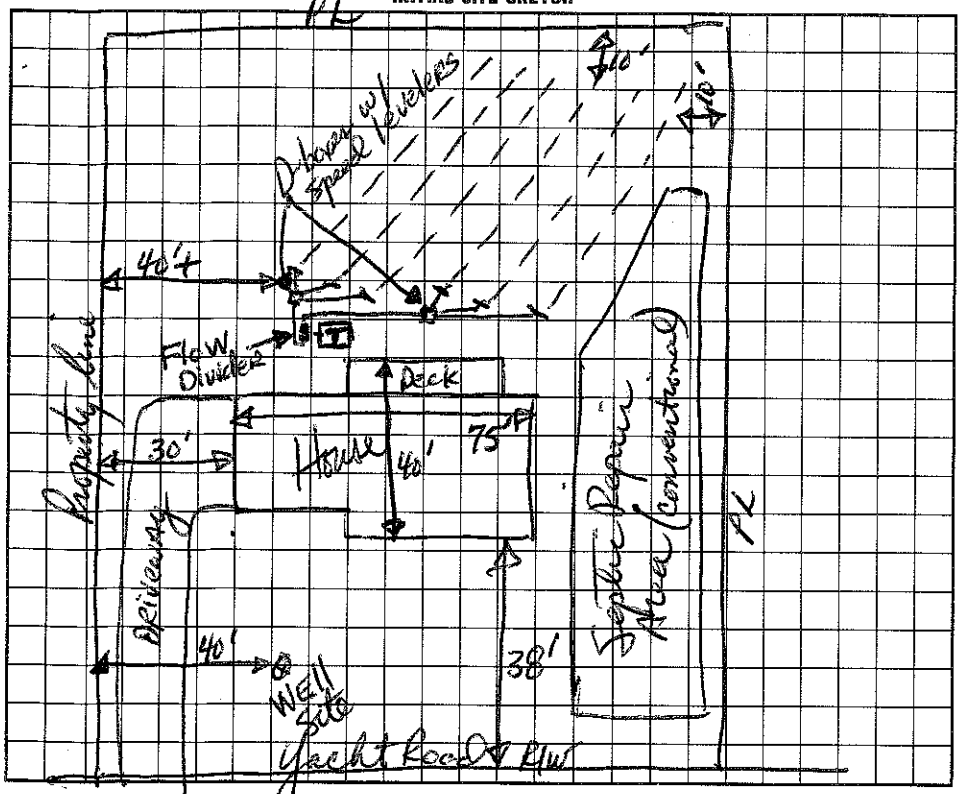

AS BUILT SKETCH

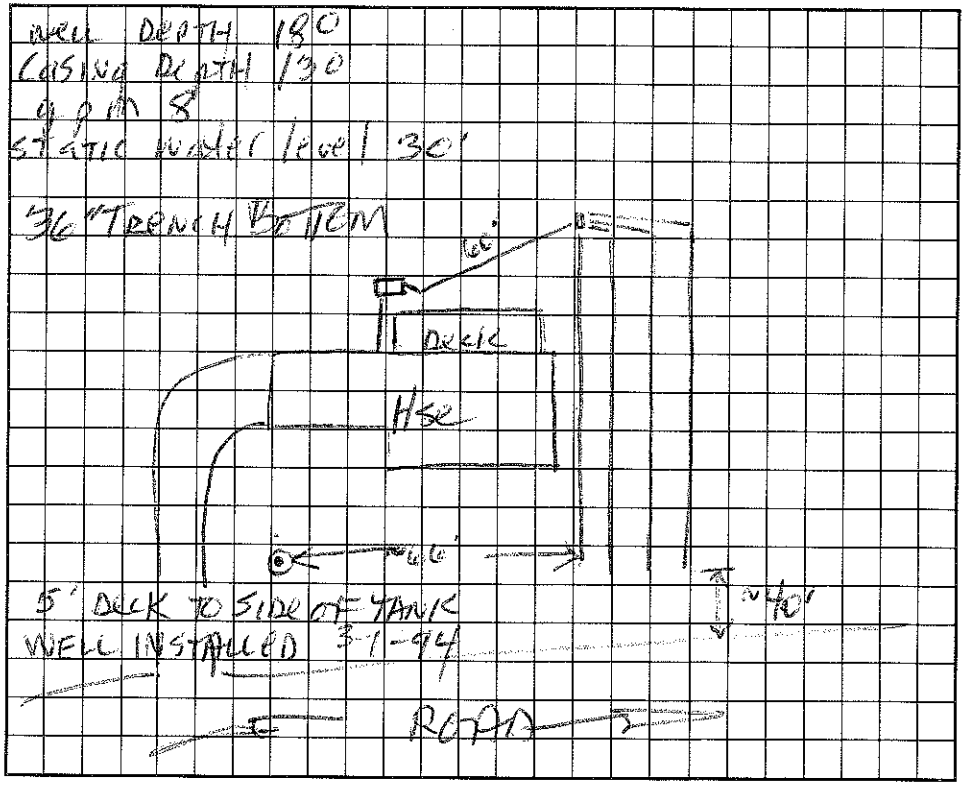

I understand that this permit can be suspended or revoked if any false information is supplied toward securing the permit/any unauthorized changes are made to the site/any unauthorized changes are made in the installation of the system. Improvement Permit is valid for 60 months from date of issuance.

Signed:

Improvement Permit by: date 10/26/93

Existing System Inspection by: date

Installed by: MacLeod Construction

Certificate of Completion by: Andrea Lemon date 3-11-94

Operation Permit by: date

HEALTH DEPT. COPY: WHITE INSPECTION COPY (FINAL): GREEN OWNER COPY (FINAL): YELLOW INSPECTION COPY (INITIAL): PINK OWNER COPY (INITIAL): GOLD