IREDELL COUNTY HEALTH DEPARTMENT

STATESVILLE 704-878-5305 MOORESVILLE 704-664-5281

IMPROVEMENT PERMIT / CERTIFICATE OF COMPLETION / OPERATION PERMIT / EXISTING SYSTEM INSPECTION

PROPERTY DESCRIPTION NO. 16858 DATE Sept 7, 93

OWNER OR CONTRACTOR Bob Brainard / New Trend Homes TAX MAP NO. 2C24

ADDRESS PHONE: Business 4625 80 7158 Home

LOCATION 1100 Ft 1101 ~½ mile on left

SUBDIVISION Yadkin Cove BLOCK / SECTION LOT 4 LOT AREA 146'x147' SITE CLASS. B per 1996 L.T.A.R. .3 gal/ft²/day

Water Supply: ☐ Individual ☐ Community ☐ Public

Septic Tank: 1000 Gallons; STB H-7175 CS - Lancaster SC Date 1-18-94

Pump Tank: Gallons; PT Date

Nitrification Field: No Fields 1 Square Feet 1200 Linear Feet 400

No. Lines 4 Trench Width 36" Trench Depth 24-30" Gravel Depth 12"

☑ New System ☐ Repair System Type: I, II, III, IV, V, VI

System Description: Gravity Conventional

Repair System Description: Gravity PPBPS

Maintenance Agreement Required: ☐ Yes ☑ No

☑ House/Mod. Home ☐ Mobile Home ☐ Business ☐ Other

No. Bedrooms 3 No. Bathrooms 2½ No. Employees

☐ Slab ☑ Crawl Space ☐ Basement w/plumbing ☐ Basement wo/plumbing

Garbage Disposal: ☑ Yes ☐ No


Auto. Dishwasher: ☑ Yes ☐ No

Auto. Washing Machine: ☑ Yes ☐ No

Other

Comments

INITIAL SITE SKETCH

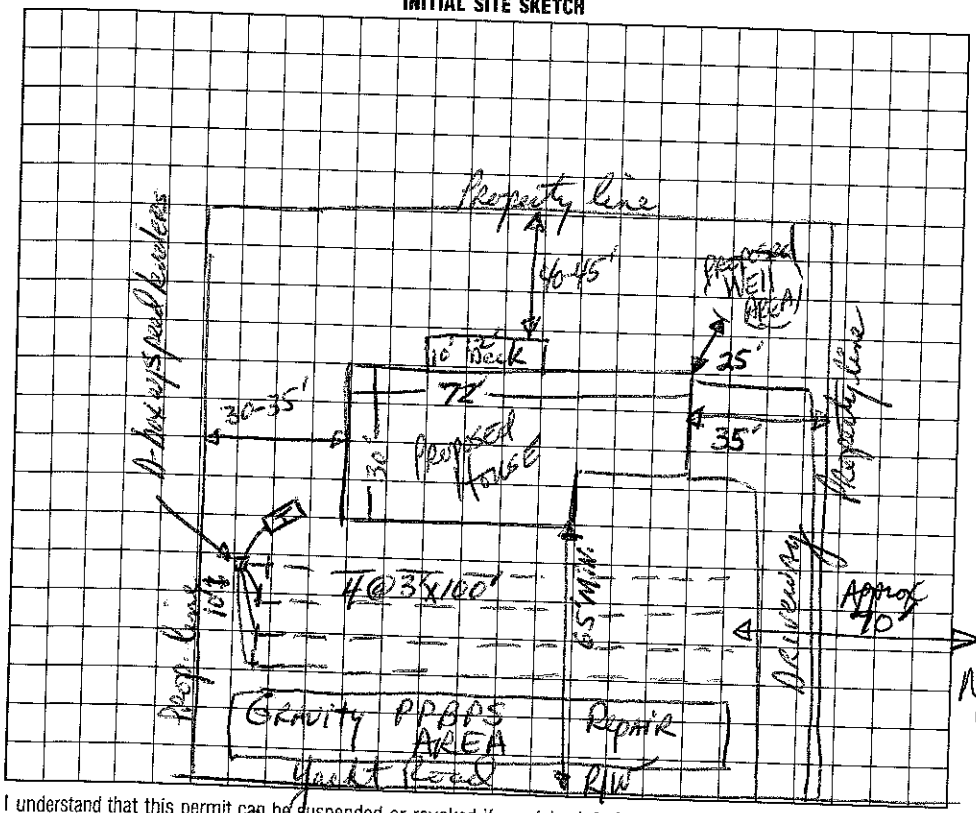

AS BUILT SKETCH

Substantially as shown on initial sketch

I understand that this permit can be suspended or revoked if any false information is supplied toward securing the permit/any unauthorized changes are made to the site/any unauthorized changes are made in the installation of the system. Improvement Permit is valid for 60 months from date of issuance.

Signed: 11/12/93

Improvement Permit by: date 9/7/93

Existing System Inspection by: date

Installed by: WT Norwood Waxhaw 843-3298

Certificate of Completion by: date 3/17/94

Operation Permit by: date

HEALTH DEPT. COPY: WHITE INSPECTION COPY (FINAL): GREEN OWNER COPY (FINAL): YELLOW INSPECTION COPY (INITIAL): PINK OWNER COPY (INITIAL): GOLD