# IREDELL COUNTY HEALTH DEPARTMENT

STATESVILLE 704-878-5305 MOORESVILLE 704-664-5281

## IMPROVEMENT PERMIT / CERTIFICATE OF COMPLETION / OPERATION PERMIT / EXISTING SYSTEM INSPECTION

PROPERTY DESCRIPTION NO. 16569 DATE July 27, '93

OWNER OR CONTRACTOR ~~Owen Contracting~~ Charles W. Hatwell TAX MAP NO. 2C2A5

ADDRESS 607 Anderson Ave, Salisbury NC 28144 PHONE: Business 636-7954 Home 4625807323

LOCATION 1100 TL1101 on left corner lot just past Yacht Cove Lane

SUBDIVISION Yacht Cove BLOCK / SECTION ____ LOT 5 LOT AREA ~21,000ft² SITE CLASS. PS L.T.A.R. .3gal/ft²/day

Water Supply: ☑ Individual ☐ Community ☐ Public

Septic Tank: 1000 Gallons; STB 794 Dellinger Date Jan 6, '94

Pump Tank: ____ Gallons; PT ____ Date ____

Nitrification Field: No Fields 1 Square Feet 1200 Linear Feet 400

No Lines 3 Trench Width 36" Trench Depth ~30" Gravel Depth 12"

☑ New System ☐ Repair System Type: I, (II), III, IV, V, VI

System Description: gravity conventional

Repair System Description: SAME OR gravity PPBPS

Maintenance Agreement Required: ☐ Yes ☑ No

☑ House/Mod. Home No. Bedrooms 3

☐ Mobile Home No. Bathrooms 2½

☐ Business No. Employees ____

☐ Other ____

☐ Slab ☑ Crawl Space ☐ Basement w/plumbing ☐ Basement wo/plumbing

Garbage Disposal: ☐ Yes ☑ No


Auto. Dishwasher: ☑ Yes ☐ No

Auto. Washing Machine: ☑ Yes ☐ No

Other ____

Comments This permit replaces one issued 6/30/93

**INITIAL SITE SKETCH**

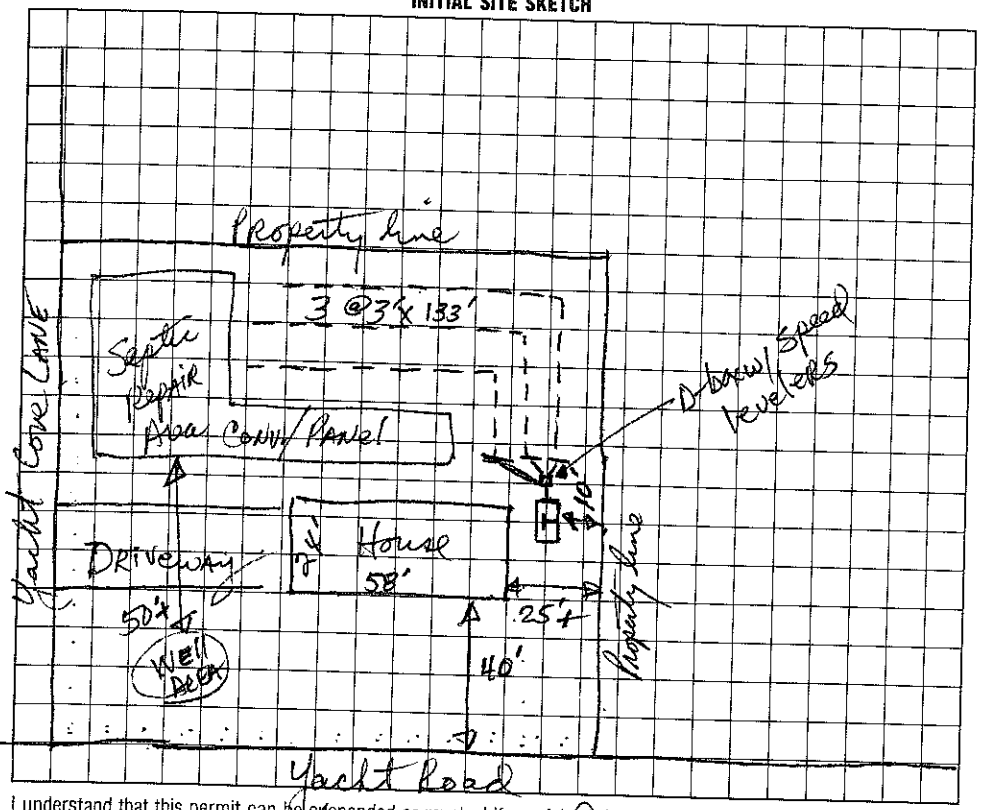


**AS BUILT SKETCH**

Substantially as shown on initial sketch

I understand that this permit can be suspended or revoked if any false information is supplied toward securing the permit/any unauthorized changes are made to the site/any unauthorized changes are made in the installation of the system. Improvement Permit is valid for 60 months from date of issuance.

Signed: ____

Improvement Permit by: Jack R. Hinson, RS date 7/27/93

Existing System Inspection by: ____ date ____

Installed by: ____

Certificate of Completion by: Jack R. Hinson, RS date 2/8/94

Operation Permit by: ____ date ____

HEALTH DEPT. COPY: WHITE INSPECTION COPY (FINAL): GREEN OWNER COPY (FINAL): YELLOW INSPECTION COPY (INITIAL): PINK OWNER COPY (INITIAL): GOLD