IREDELL COUNTY HEALTH DEPARTMENT

STATESVILLE 704-878-5305 MOORESVILLE 704-664-5281

IMPROVEMENT PERMIT / CERTIFICATE OF COMPLETION / OPERATION PERMIT / EXISTING SYSTEM INSPECTION

PROPERTY DESCRIPTION NO. 17373 DATE Feb 22, '94 TAX MAP NO. 2C2A27

OWNER OR CONTRACTOR Charles J. Gilley Jr. PHONE: Business _____ Watershed: ☑ Yes ☐ No

ADDRESS 20333 Haven View Dr. J J Davidson 28036 Home 896-7333 L.N.

LOCATION Hwy TL 1101 ¼ mile on left 4625807860

SUBDIVISION Yacht Cove BLOCK / SECTION _____ LOT 27 LOT AREA 1.674 Ac SITE CLASS PS per 1956 DESIGN FLOW 360 gpd L.T.A.R. .3

Septic Tank: 1600 Gallons; STB 794 Date 7/25/94

Pump Tank: _____ Gallons; PT _____ Date _____

Pump Make: _____ Model _____ Serial No. _____

Nitrification Field: No Fields 2 Square Feet _____ Linear Feet 200

No Lines 4 Trench Width 24" Max Trench Bottom Depth 36"

☑ New System ☐ Repair System Type: I, II, III, IV, V, VI

System Description: Gravity LPP BPS

Repair System Description: LPP LPBPS

Maintenance Agreement Required: ☐ Yes ☑ No

Gravel Depth NA

☑ House/Mod. Home No. Bedrooms 3

☐ Mobile Home No. Bathrooms 3½

☐ Business No. Employees _____

☐ Other _____


☐ Slab ☑ Crawl Space ☐ Basement w/plumbing ☐ Basement wo/plumbing

Water Supply: ☑ Individual ☐ Community ☐ Public

Comments: Exit plumbing at existing grade. KEEP Laterals shallow.

Comments: Installed as shown on Imp. Permit

INITIAL SITE SKETCH

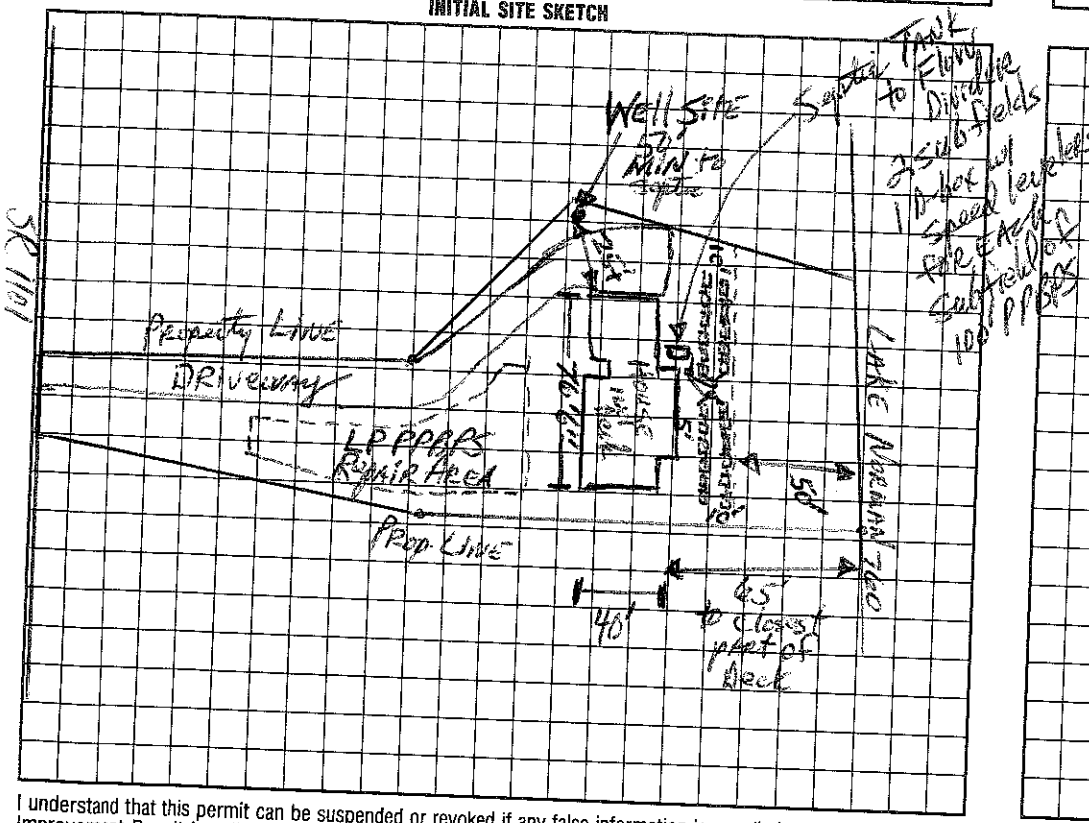

AS BUILT SKETCH

I understand that this permit can be suspended or revoked if any false information is supplied toward securing the permit/any unauthorized changes are made to the site/any unauthorized changes are made in the installation of the system. Improvement Permit is valid for 60 months from date of issuance.

Signed: Charles J. Gilley Jr.

Improvement Permit by: David K. Hanson, RS date 2/22/94

Existing System Inspection by: _____ date _____

Installed by: Barry Thompson

Certificate of Completion by: Wesley Sparks RS. date 9/28/94

Operation Permit by: _____ date _____

HEALTH DEPT. COPY: WHITE INSPECTION COPY (FINAL): GREEN OWNER COPY (FINAL): YELLOW INSPECTION COPY (INITIAL): PINK OWNER COPY (INITIAL): GOLD