IREDELL COUNTY HEALTH DEPARTMENT

STATESVILLE 704-878-5305 MOORESVILLE 704-664-5281

IMPROVEMENT PERMIT / CERTIFICATE OF COMPLETION / OPERATION PERMIT / EXISTING SYSTEM INSPECTION

PROPERTY DESCRIPTION NO. 20929 DATE May 3, 195 TAX MAP NO. 2C2A6 Watershed: ☑ Yes ☐ No

OWNER OR CONTRACTOR Steven and Nan Rex PHONE: Business _____ Home _____ WSIV

ADDRESS 7196 Executive Circle Denver NC 28037 4625 80 83816

LOCATION Brawley Sch Rd. To Yacht Rd To Yacht Cove Lane on Right

SUBDIVISION Yacht Cove BLOCK / SECTION _____ LOT 6 LOT AREA .72Ac SITE CLASS. PS pa1956 DESIGN FLOW 480 gpd L.T.A.R. .3

Septic Tank: 1000 Gallons; STB 825 Date 10/24/95

Pump Tank: _____ Gallons; PT _____ Date _____

Pump Make: _____ Model _____ Serial No. _____

Nitrification Field: No Fields 1 Square Feet 1200 Linear Feet 400

No Lines 4 Trench Width 36" Max Trench Bottom Depth 36"

☑ New System ☐ Repair System Type: I, II, III, IV, V, VI

System Description: Gravity Infiltrator

Repair System Description: 1 Some

Maintenance Agreement Required: ☐ Yes ☑ No

Gravel Depth NA

☑ House/Mod. Home No. Bedrooms 4

☐ Mobile Home No. Bathrooms 3

☐ Business No. Employees ____

☐ Other _____

☐ Slab ☑ Crawl Space ☐ Basement w/plumbing ☐ Basement wo/plumbing

Water Supply: ☑ Individual ☐ Community ☐ Public


Comments:

Comments:

Installed as drawn on my Permit

1" = 50'

INITIAL SITE SKETCH

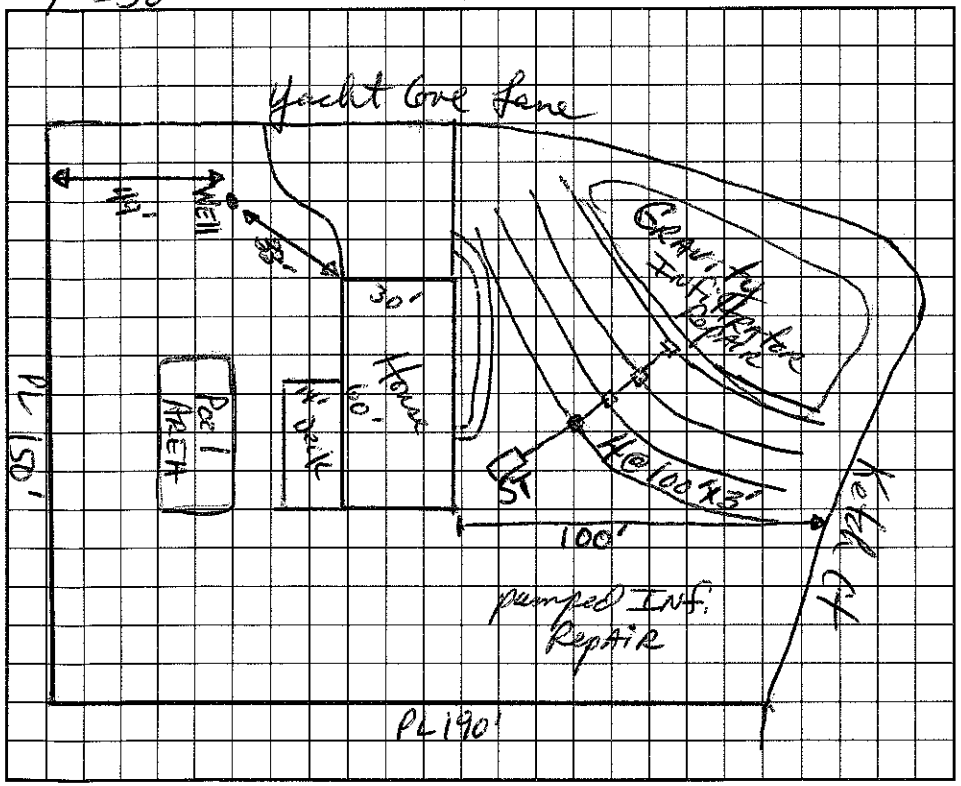

AS BUILT SKETCH

I understand that this permit can be suspended or revoked if any false information is supplied toward securing the permit/any unauthorized changes are made to the site/any unauthorized changes are made in the installation of the system. Improvement Permit is valid for 60 months from date of issuance.

Signed: X

Improvement Permit by: _____ date 5/3/95

Existing System Inspection by: _____ date _____

Installed by: Tim Ammons

Certificate of Completion by: Wesley Sparks RS date 11/22/95

Operation Permit by: Wesley Sparks RS date 11/22/95

HEALTH DEPT. COPY: WHITE INSPECTION COPY (FINAL): GREEN OWNER COPY (FINAL): YELLOW INSPECTION COPY (INITIAL): PINK OWNER COPY (INITIAL): GOLD