IREDELL COUNTY HEALTH DEPARTMENT

Authorization to Construct

STATESVILLE 704-878-5305 MOORESVILLE 704-664-5281

IMPROVEMENT PERMIT / ~~CERTIFICATE OF COMPLETION~~ / OPERATION PERMIT / EXISTING SYSTEM INSPECTION

PROPERTY DESCRIPTION NO. 23520 DATE 5/9/96 TAX MAP NO. 2C 2 23 4625 80 8589 Watershed: ☒ Yes ☐ No

OWNER OR CONTRACTOR John C Brauninger PHONE: Business 896-8991 Home 948-0042

ADDRESS 14204 Boatway Ct. Huntersville, NC. 28078

LOCATION Yacht Rd. Brawl Sch TL Yacht R on Wally TL Yacht Cove to 2ND lot on (L)

SUBDIVISION Yacht Cove BLOCK / SECTION 1 LOT 23 LOT AREA ~.76 SITE CLASS. PS DESIGN FLOW 480 L.T.A.R. .3

Septic Tank: 1000 Gallons; STB 794 Date 2/24/97

Pump Tank: 1000 Gallons; PT 794 Date 2/24/97

Pump Make: Hydromatic Model M-50AA Serial No.

Nitrification Field: No Fields 1 Square Feet 1600 Linear Feet ~399

No Lines 4 Trench Width 36" Max Trench Bottom Depth 32" Gravel Depth 6" SAND

☒ New System ☐ Repair System Type: I, II, (III), IV, V, VI

System Description: Pres Manifold to Ch Plastic

Repair System Description: Paved

Maintenance Agreement Required: ☐ Yes ☒ No

☒ House/Mod. Home ☐ Mobile Home ☐ Business ☐ Other

No. Bedrooms 4 No. Bathrooms 3 No. Employees


☐ Slab ☐ Crawl Space ☒ Basement w/plumbing ☐ Basement wo/plumbing

Water Supply: ☒ Individual ☐ Community ☐ Public


Comments: 150 GALS PER DOSE = 8" Drawdown
NEMA 4X ELECTRICAL BOX - SEPERATE CIRCUITS FOR PUMP AND ALARM - WELL MUST BE IN REAR (LAKESIDE OF HOUSE

Comments:

INITIAL SITE SKETCH

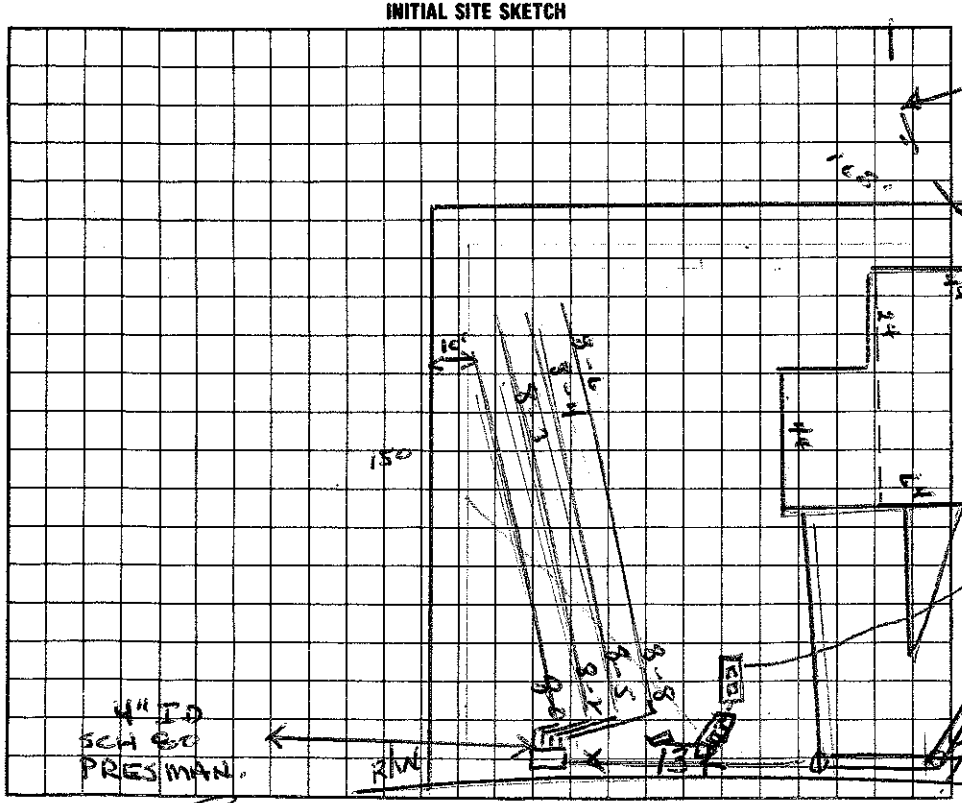

AS BUILT SKETCH

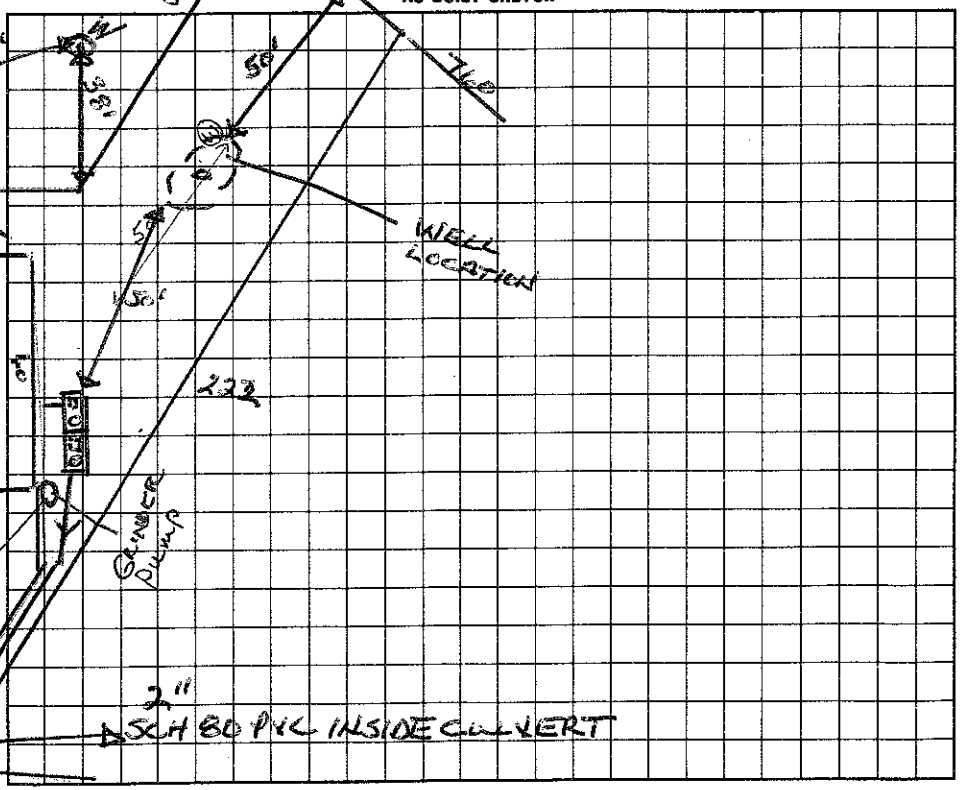

I understand that this permit can be suspended or revoked if any false information is supplied toward securing the permit/any unauthorized changes are made to the site/any unauthorized changes are made in the installation of the system.

YACHT COVE RD.

Signed: John C Brauninger

Improvement Permit by: Wesley Sparks RS. date 5/9/96

Existing System Inspection by: Construct Wesley Sparks RS date 5/9/96

Installed by: Bob Mayhew

Certificate of Completion by: Wesley Sparks RS. date 7/14/97

Operation Permit by: Wesley Sparks RS. date 7/14/97

HEALTH DEPT. COPY: WHITE INSPECTION COPY (FINAL): GREEN OWNER COPY (FINAL): YELLOW INSPECTION COPY (INITIAL): PINK OWNER COPY (INITIAL): GOLD