IREDELL COUNTY HEALTH DEPARTMENT

Authorization to Construct

STATESVILLE 704-878-5305 MOORESVILLE 704-664-5281

IMPROVEMENT PERMIT / ~~CERTIFICATE OF COMPLETION~~ / OPERATION PERMIT / EXISTING SYSTEM INSPECTION

PROPERTY DESCRIPTION NO. 24081 DATE 2/10/97 TAX MAP NO. 4625808710 Watershed: [X] Yes [ ] No

OWNER OR CONTRACTOR Judith + Jerry Deal PHONE: Business _____ Home Lkt. 8301

ADDRESS 115 Yacht Cove Lane

LOCATION Yacht Cove Rd - 1100 Ft Yacht Rd To Yacht Cove 1st (L) to House

SUBDIVISION Yacht Cove BLOCK / SECTION _____ LOT 24 LOT AREA Existing SITE CLASS. _____ DESIGN FLOW _____ L.T.A.R. _____

Septic Tank: Existing Gallons; STB _____ Date _____

Pump Tank: Existing Gallons; PT _____ Date _____

Pump Make: _____ Model _____ Serial No. _____

Nitrification Field: No Fields ____ Square Feet Existing Linear Feet _____

No Lines _____ Trench Width _____ Max Trench Bottom Depth _____ Gravel Depth _____

[ ] New System [ ] Repair System Type: I, II, III (IV) V, VI

System Description: Existing System

Repair System Description: _____

Maintenance Agreement Required: [ ] Yes [ ] No

[ ] House/Mod. Home No. Bedrooms 3

[ ] Mobile Home No. Bathrooms 2

[ ] Business No. Employees ____

[X] Other Added Garage

[X] Slab [ ] Crawl Space [ ] Basement w/plumbing [ ] Basement wo/plumbing


Water Supply:
[X] Individual
[ ] Community
[ ] Public

Comments:

Comments:

INITIAL SITE SKETCH

AS BUILT SKETCH

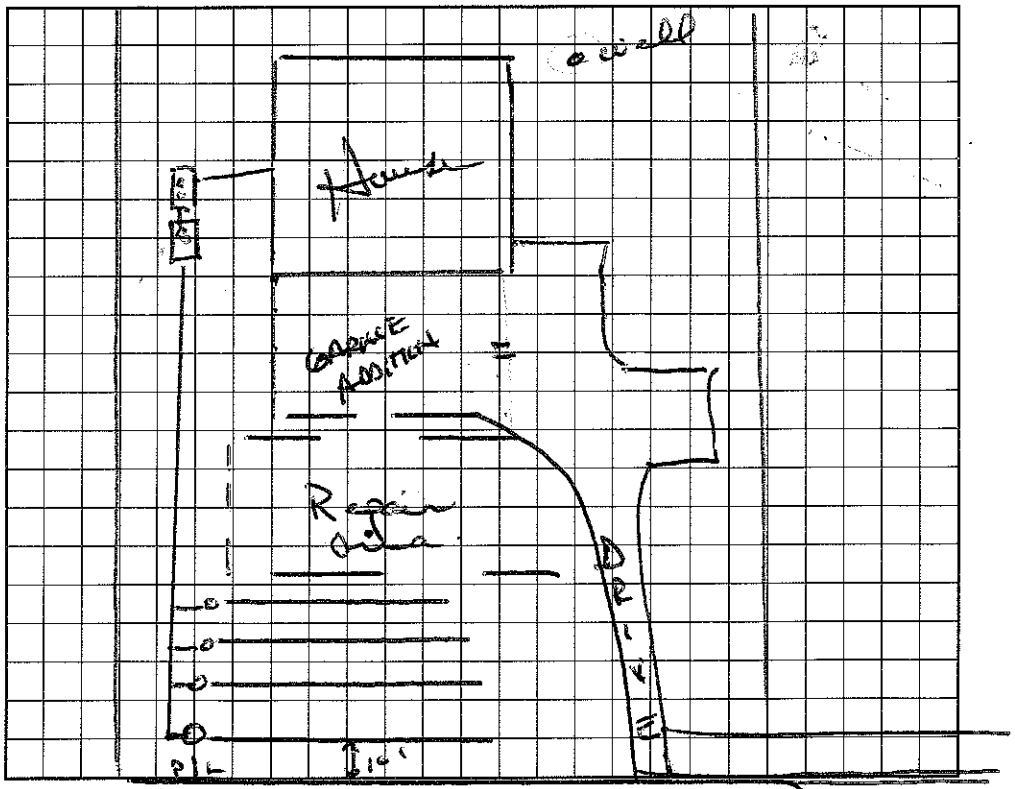

I understand that this permit can be suspended or revoked if any false information is supplied toward securing the permit/any unauthorized changes are made to the site/any unauthorized changes are made in the installation of the system.

Signed: _____

Improvement Permit by: _____ date _____

Existing System Inspection by: _____ date _____

Installed by: Existing System

Certificate of Completion by: Wesley Sparks RS date 2/10/97

Operation Permit by: Wesley Sparks RS date 2/10/97

HEALTH DEPT. COPY: WHITE INSPECTION COPY (FINAL): GREEN OWNER COPY (FINAL): YELLOW INSPECTION COPY (INITIAL): PINK OWNER COPY (INITIAL): GOLD