IREDELL COUNTY HEALTH DEPARTMENT

STATESVILLE 704-878-5305 | MOORESVILLE 704-664-5281

4625809017

IMPROVEMENT PERMIT / CERTIFICATE OF COMPLETION / OPERATION PERMIT / EXISTING SYSTEM INSPECTION

PROPERTY DESCRIPTION NO 17518 DATE Dec 6, '93 TAX MAP NO 2C-2A 8

OWNER OR CONTRACTOR Jimmie Rae Robbs PHONE: Business 825-0680 (Hopkins Const) Home Watershed: ☐ Yes ☐ No LN

ADDRESS 2121-269 Regatta Dr. Denver NC

LOCATION 1100 ft (101 (Jacobs Rd.) to Yacht Cove Ln. to Ketch Ct. on Rt. in Cul-de-sac

SUBDIVISION Yacht Cove BLOCK / SECTION LOT 8 LOT AREA SITE CLASS B on R&S DESIGN FLOW 360 gpd L.T.A.R. .3

Septic Tank 1000 Gallons; STB 794 Ballinger Date 3-23-94

Pump Tank: Gallons; PT Date

Pump Make: Model Serial No.

Nitrification Field: No Fields 1 Square Feet 400 Linear Feet 200

No Lines 3 Trench Width 24" Max Trench Bottom Depth 36" Gravel Depth N/A

☑ New System ☐ Repair System Type: I II III IV V VI (CW)

System Description: gravity PPBPS conv

Repair System Description: ~~same~~ gravity PPBPS

Maintenance Agreement Required: ☐ Yes ☑ No

☑ House/Mod. Home No. Bedrooms 3

☐ Mobile Home No. Bathrooms 2

☐ Business No. Employees

☐ Other

☐ Slab ☑ Crawl Space ☐ Basement w/plumbing ☐ Basement wo/plumbing


Water Supply: ☑ Individual ☐ Community ☐ Public

Comments: follow contour with laterals


4/27/94 - Revisited site, initial system will go in conventional (400') w/ PPBPS repair area

Comments:

INITIAL SITE SKETCH

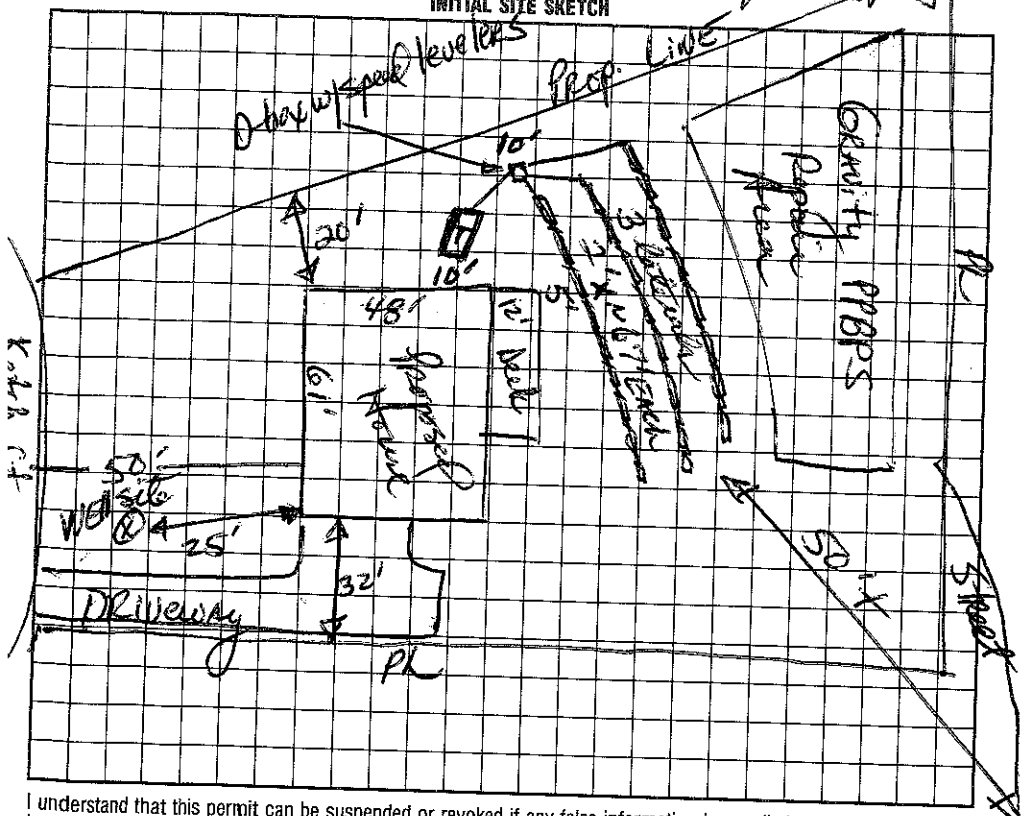

AS BUILT SKETCH

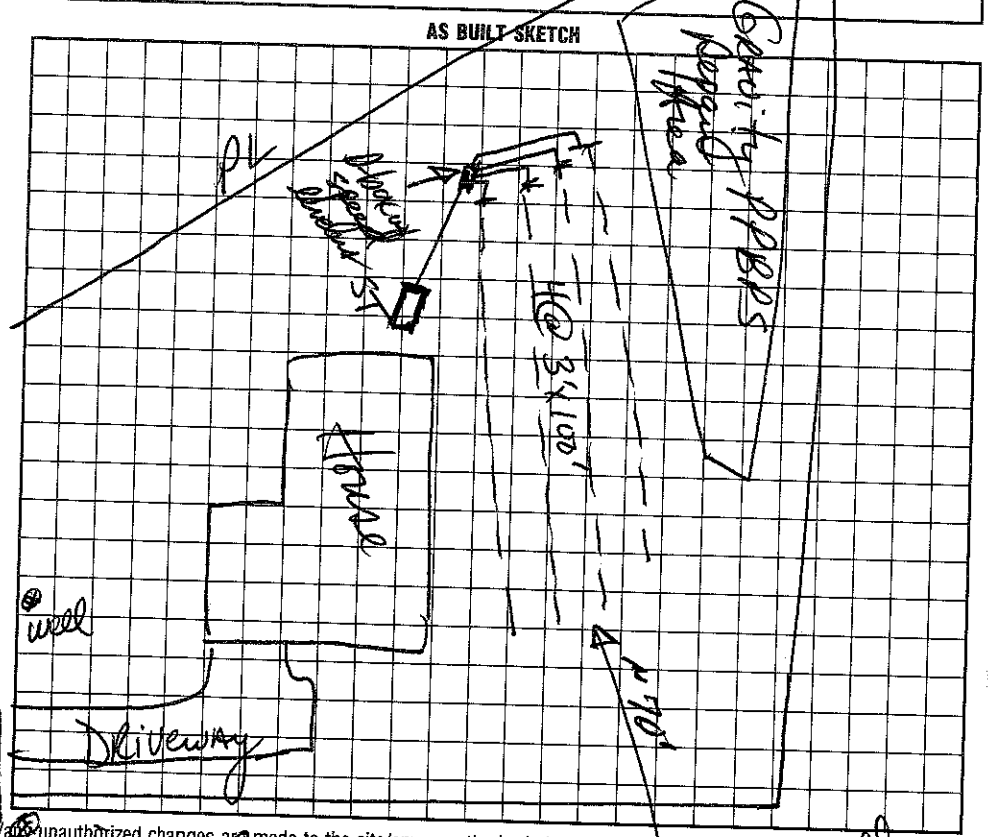

I understand that this permit can be suspended or revoked if any false information is supplied toward securing the permit and unauthorized changes are made to the site/any unauthorized changes are made in the installation of the system. Improvement Permit is valid for 60 months from date of issuance.

Signed:

Improvement Permit by: David R. Hinson, RS date 12/6/93

Existing System Inspection by: date

Installed by: Bobby Mayhew

Certificate of Completion by: David R Hinson RS Neighbors well date 5/18/94

Operation Permit by: date

HEALTH DEPT. COPY: WHITE | INSPECTION COPY (FINAL): GREEN | OWNER COPY (FINAL): YELLOW | INSPECTION COPY (INITIAL): PINK | OWNER COPY (INITIAL): GOLD

Diane 704-660-5426