IREDELL COUNTY HEALTH DEPARTMENT

ONES 20.00 Existing System

STATESVILLE 704-878-5305 MOORESVILLE 704-664-5281

IMPROVEMENT PERMIT / AUTHORIZATION TO CONSTRUCT / OPERATION PERMIT / EXISTING SYSTEM INSPECTION

PERMIT# 146530 PIN# 4625809017.000

OWNER OR APPLICANT William + Diane Kissel PHONE: Business 704660-5426 Home DATE 7/8/08

ADDRESS 116 Ketch Ct Mooresville NC 28117

LOCATION Brawley School Rd. TL Yacht Rd. TL Yacht Cove TR Ketch Ct 116 Ketch Ct. on Right at Culdesac

SUBDIVISION Yacht Cove BLOCK / SECTION LOT 8 LOT AREA SITE CLASS PS DESIGN FLOW 360 L.T.A.R. e 3

Septic Tank Exis 1000 Gallons: STB Date

Pump Tank: Gallons: PT Date

Pump Make: Model Serial No.

Nitrification Field: No Fields 1 Square Feet Linear Feet 400+Exis

No Lines Exis 4 @ 100' Trench Width 36" Max Trench Bottom Depth Exis Gravel Depth ☐ Gravity ☐ Pressure

☐ New System ☐ Repair ☐ Expansion System Type: I (II) III IV V VI

System Description: Existing System

Repair System Description: LPP PBS System

Maintenance Agreement Required: ☐ Yes ☑ No

☑ House/Mod. Home No. Bedrooms 3

☐ Mobile Home No. Persons

☐ Business No. Employees

☐ Other

Water Supply: ☑ Individual Exis ☐ Public ☐ Community


☐ Slab ☑ Crawl Space ☐ Basement w/plumbing ☐ Basement wo/plumbing

Comments:/Conditions:

Comments:/Conditions: See Exis Permit "Jimmie Rae Robbs - 1994"

INITIAL SITE SKETCH

AS BUILT SKETCH

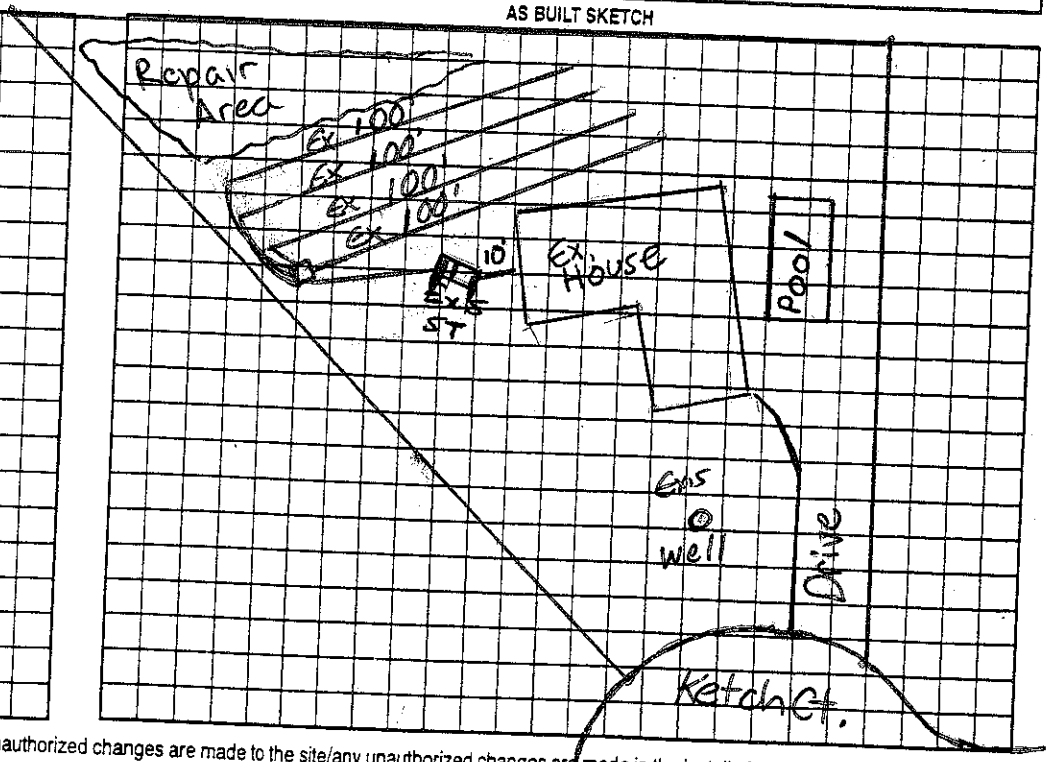

Permit can be suspended or revoked if any false information is supplied toward securing the permit/any unauthorized changes are made to the site/any unauthorized changes are made in the installation of the system. Improvement Authorization to Construct is valid for a period equal to that of Improvement Permit – not to exceed sixty months.

Permit with plat valid without expiration ☐ Improvement Permit with site plan valid for sixty months ☐

Signed: date 7-8-08

Improvement Permit by: date

Authorization to Construct by: date

Installed by:

Operation Permit by: date

Existing System Inspection by: Anthony Cole Jr date 7/8/08

HEALTH DEPT. COPY: WHITE OWNER COPY (FINAL): YELLOW OWNER COPY (INITIAL): PINK