Site: 116 Ketch Court

IREDELL COUNTY HEALTH DEPARTMENT

STATESVILLE 704-878-5305 MOORESVILLE 704-664-5281

6605436

IMPROVEMENT PERMIT / AUTHORIZATION TO CONSTRUCT / OPERATION PERMIT / EXISTING SYSTEM INSPECTION

PERMIT # 1634291 PIN # 4602580901 DATE 10-14-2010

OWNER or APPLICANT Carolina Home Remodeling/William Curt Kissel PHONE: Business 704 277-3403 Home: Dianne 704 932-3193

OWNER or APPLICANT ADDRESS 11409 McGinns Place Ct. Charlotte, NC 28277

LOCATION / DIRECTIONS Brawley School Rd TL Yacht Rd TL Yacht Cove Ln TR Ketch Ct. on right in cul-de-sac

SUBDIVISION Yacht Cove BLOCK / SECTION LOT # 8 LOT AREA 36000 sq ft DESIGN FLOW L.T.A.R. .3

Exist Septic Tank 1000 Gallons: STB Date

Pump Tank Gallons: P T Date

Pump Make Model Serial #

Nitrification Field No Fields 1 No Lines 4 Linear Feet 400'

Trench Width 36" Max. Trench Bottom Depth Exist. Gravel Depth 12"

☐ New System ☐ Repair ☐ Expansion System Type I (II) III IV V VI

System Description: Exist Gravity - Conventional

Repair System Description: LPPPBRS

Maintenance Agreement Required ☐ YES ☒ NO

☒ GRAVITY ☐ PRESSURE

☒ Residence No. Bedrooms 3 ☐ Business No. Persons ☐ Other No. Employees ☐ Slab ☐ Crawl Space ☐ Basement w/plumbing ☐ Basement w/o plumbing


Water Supply: ☒ Private ☐ Public ☐ Community

Comments / Conditions: Existing Septic System appears to be functioning okay at time of inspection. Proposed Sunroom will be in same place as existing structure.

Comments / Conditions: Must keep construction traffic off of ST & Drainfield otherwise Septic System maybe damaged & repair will be needed

INITIAL SITE SKETCH

AS BUILT SKETCH

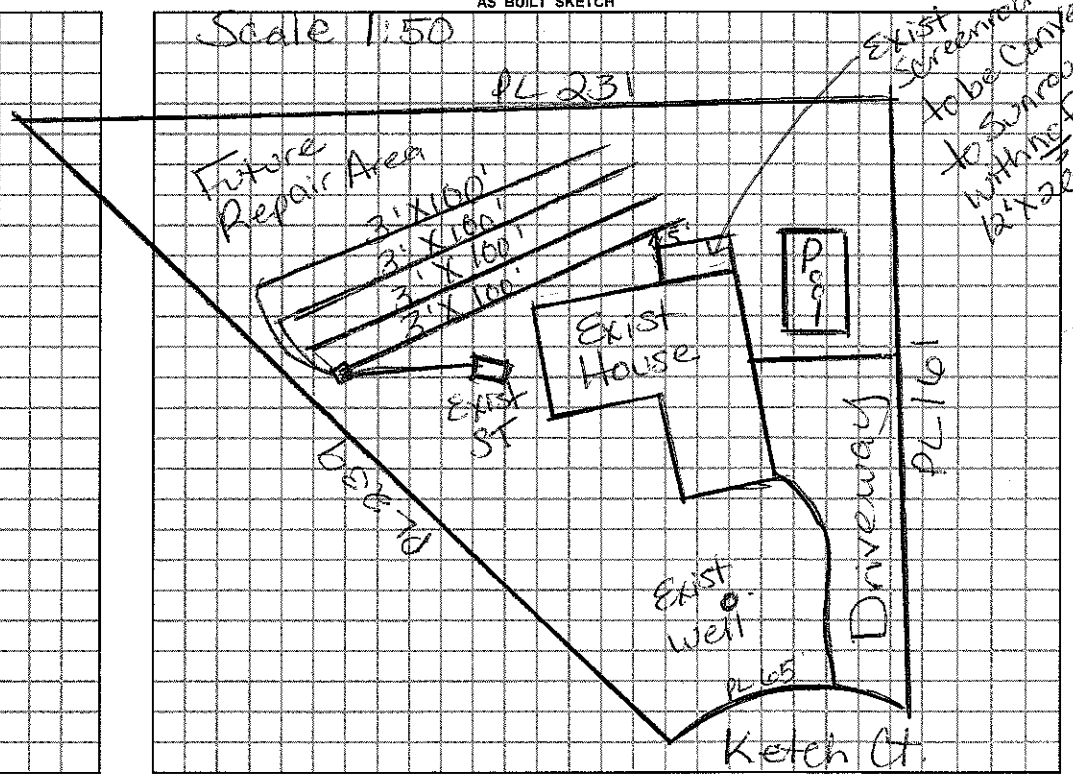

Permit can be suspended or revoked if any false information is supplied toward securing the permit / any unauthorized changes are made to the site / any unauthorized changes are made in the installation of the system.

☐ *IMPROVEMENT PERMIT w / plat valid without expiration.* ☐ *IMPROVEMENT PERMIT w / site plan valid for 60 mos.* ☐ *AUTHORIZATION TO CONSTRUCT valid for period equal to IMPROVEMENT PERMIT-not to exceed 60 mo.*

Owner / Applicant Signature: Curt Kissel Date 10-29-10

Improvement Permit by: Date

Authorization to Construct by: Date

YOU SHOULD CONTACT A LOCATOR SERVICE PRIOR TO ANY EXCAVATION.

Installed by: Bobby Mayhew on 5/18/94

Operation Permit by: Date:

Existing System Inspected by: Maina Hill Evans RS Date: 10/29/2010

WHITE COPY Environmental Health YELLOW COPY (Final) Owner / Applicant PINK COPY (Initial) Owner / Applicant