IREDELL COUNTY HEALTH DEPARTMENT

STATESVILLE 704-878-5305 MOORESVILLE 704-664-5281

IMPROVEMENT PERMIT / CERTIFICATE OF COMPLETION / OPERATION PERMIT / EXISTING SYSTEM INSPECTION

PROPERTY DESCRIPTION NO. 11587 DATE 7/1/93

OWNER OR CONTRACTOR ALBERT E ROWLAND

ADDRESS KETCH COURT MOORESVILLE, NC. PHONE: Business 4625809092 Home

TAX MAP NO. 2C 2A 7

LOCATION YACHT COVE - 1100 TL ON YACHT RD. (R) ON WORLEY RD, TL INTO YACHT COVE TR 1ST ROAD

SUBDIVISION YACHT COVE BLOCK / SECTION LOT 7 LOT AREA 154 x 191' SITE CLASS. P L.T.A.R. .25 - .3

Water Supply: ☑ Individual ☐ Community ☐ Public

Septic Tank: 1000 Gallons; STB 358 Date 3/22/93

Pump Tank: Gallons; PT Date

Nitrification Field: No Fields 1 Square Feet Linear Feet 200'

No Lines 3 Trench Width 24" Trench Depth 36" ~~Gravel~~ SAND Depth 6"

☑ New System ☐ Repair System Type: I, II, (III) IV, V, VI

System Description: PREFAB PANEL 16"

Repair System Description: PREFAB PANEL 16"

Maintenance Agreement Required: ☑ Yes ☐ No 5 YR.

☑ House/Mod. Home ☐ Mobile Home ☐ Business ☐ Other

No. Bedrooms 3 No. Bathrooms 1.5 No. Employees

☑ Slab ☐ Crawl Space ☐ Basement w/plumbing

Garbage Disposal: ☐ Yes ☑ No

Auto. Dishwasher: ☑ Yes ☐ No


Auto. Washing Machine: ☑ Yes ☐ No

Other ☐ Basement wo/plumbing

Comments Septic Tank changed out for one with proper cure strength.

INITIAL SITE SKETCH

AS BUILT SKETCH

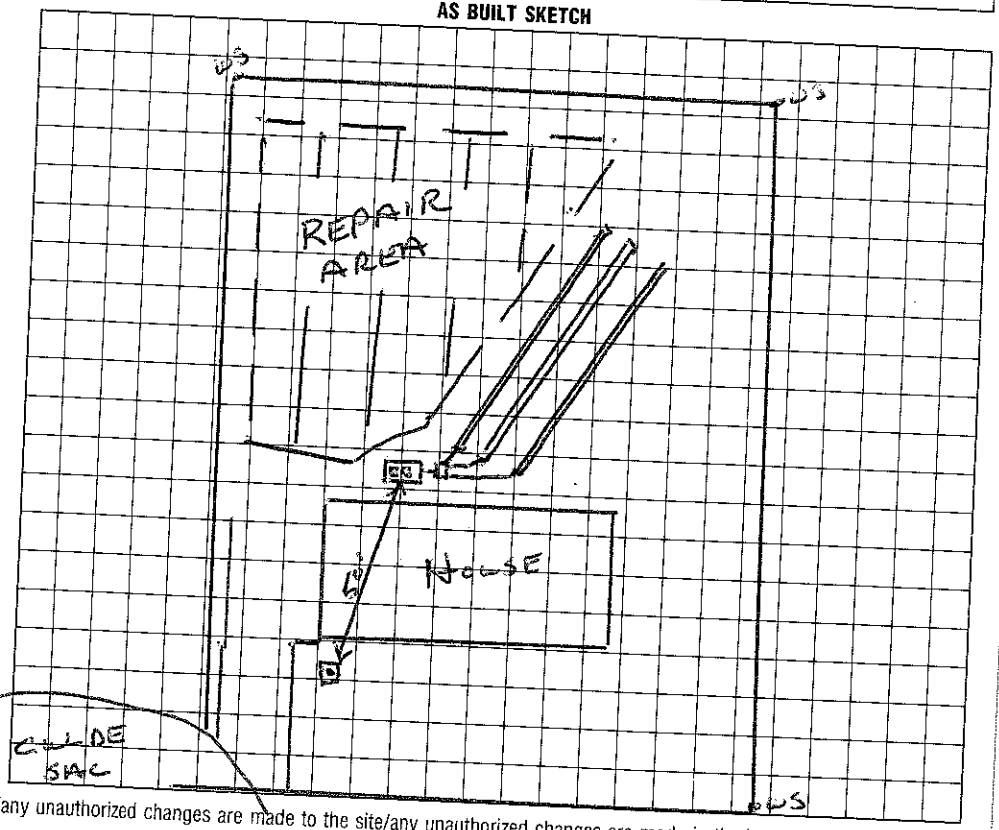

I understand that this permit can be suspended or revoked if any false information is supplied toward securing the permit/any unauthorized changes are made to the site/any unauthorized changes are made in the installation of the system. Improvement Permit is valid for 60 months from date of issuance.

Signed:

Improvement Permit by: date

Existing System Inspection by: date

Installed by: FT Ewing

Certificate of Completion by: Wesley Sparks RS. date 7/1/93

Operation Permit by: date

HEALTH DEPT. COPY: WHITE INSPECTION COPY (FINAL): GREEN OWNER COPY (FINAL): YELLOW INSPECTION COPY (INITIAL): PINK OWNER COPY (INITIAL): GOLD