IREDELL COUNTY HEALTH DEPARTMENT

STATESVILLE 704-878-5305 MOORESVILLE 704-664-5281

IMPROVEMENT PERMIT / AUTHORIZATION TO CONSTRUCT / OPERATION PERMIT / EXISTING SYSTEM INSPECTION

PERMIT# 119920 PIN# 4625884937.352 4625-81-0769 DATE 2-6-06

OWNER OR CONTRACTOR John Poore Builders PHONE: Business 847-0496 Home Bob 400-0522

ADDRESS 10590 Independence Pt Pkwy Matthews NC

LOCATION Brawley School Rd TL Yacht Rd TL Milford Circle TL Alton Ct on left

SUBDIVISION The Point BLOCK / SECTION 13 LOT 1352 LOT AREA SITE CLASS. B DESIGN FLOW 600gpd A.R. .3

Septic Tank: 1500 Gallons; STB 238 Date 3-17-06
Pump Tank: 1500 Gallons; PT 477 Date 3-25-06
Pump Make: Myers Model ME50 Serial No.
Nitrification Field: No Fields 1 Square Feet 1008 Linear Feet 336'
No Lines 4@84' Trench Width *See Note Max Trench Bottom Depth 36" Gravel Depth N/A

☒ New System ☐ Repair System Type: I, II, III, IV, V, VI
System Description: Pump-LP-Panel Blk
Repair System Description: Same
Maintenance Agreement Required: ☒ Yes ☐ No


☒ House/Mod. Home No. Bedrooms 5
☐ Mobile Home No. Bathrooms
☐ Business No. Employees
☐ Other
☐ Slab ☒ Crawl Space ☐ Basement w/plumbing ☐ Basement wo/plumbing

Water Supply:
☐ Individual
☒ Public
☒ Community

Comments:/Conditions: Note: Use trench width as specified In Crescent Communities On Site Sewage Manual

Comments:/Conditions: Checked tanks & lines, 5/17/06 mjs
Pressure, elect & alarm 5/19/06 mjs
Builder will caulk/seal elect. outlet from tank

INITIAL SITE SKETCH

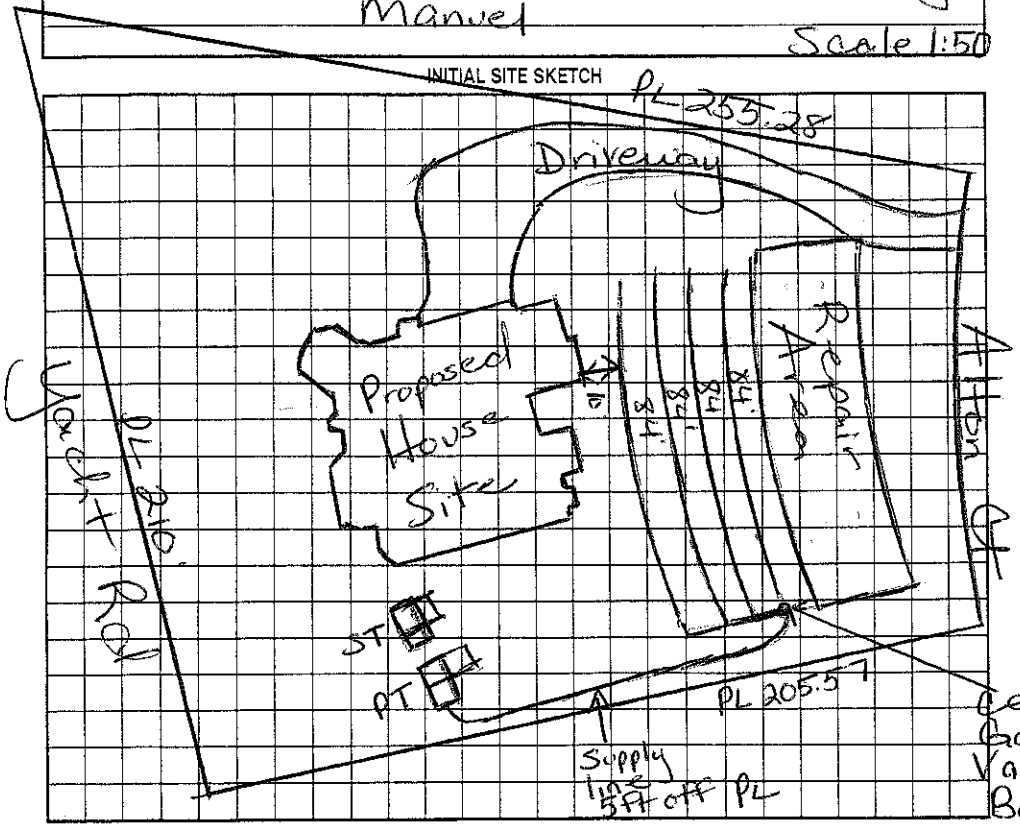

AS BUILT SKETCH

Permit can be suspended or revoked if any false information is supplied toward securing the permit/any unauthorized changes are made to the site/any unauthorized changes are made in the installation of the system. Improvement Permit with plat valid without expiration. Improvement Permit with site plan valid for sixty months. Authorization to Construct is valid for a period equal to that of Improvement Permit – not to exceed sixty months.

Signed: date 3-31-06 Installed by: RS

Improvement Permit by: Maria H. Dotson RS date 2/6/06 Operation Permit by: Maria H. Dotson RS date 5/19/06

Authorization to Construct by: Maria H. Dotson RS date 2/6/06 Existing System Inspection by: date

HEALTH DEPT. COPY: WHITE OWNER COPY (FINAL): YELLOW OWNER COPY (INITIAL): PINK