IREDELL COUNTY HEALTH DEPARTMENT

STATESVILLE 704-878-5305 MOORESVILLE 704-664-5281

IMPROVEMENT PERMIT / AUTHORIZATION TO CONSTRUCT / OPERATION PERMIT / EXISTING SYSTEM INSPECTION

PERMIT# 119917 PIN# ~~4625884937.351~~ 4625-81-0902 Gary DATE 3-21-06

OWNER OR APPLICANT Kenneth Bealer Homes PHONE: Business 662-6400 ~~Home~~ Cell 363-8891

ADDRESS 1454 Brawley School Rd Mooresville, NC 28117

LOCATION Brawley School Rd TL Yacht Rd TL Milford Circle TL Alton Ct at end

SUBDIVISION The Point BLOCK / SECTION 13 LOT 1351 LOT AREA .896 Acre SITE CLASS. RS DESIGN FLOW 600gpd L.T.A.R. .3

Septic Tank: 1500 Gallons; STB 444 Date 7-2-06
Pump Tank: 1500 Gallons; PT 477 Date 7-29-06
Pump Make: Myers Model ME50 Serial No. 05-21
Nitrification Field: (No) Fields 1 Square Feet ____ Linear Feet 335
No Lines 5 Trench Width * See note Max Trench Bottom Depth 36" Gravel Depth N/A ☐ Gravity ☐ Pressure

☒ New System ☐ Repair ☐ Expansion System Type: I II III (IV) V VI
System Description: Pump-LP-Panel Block
Repair System Description: LPPBPS
Maintenance Agreement Required: ☐ Yes ☒ No

☐ House/Mod. Home ☐ Mobile Home ☐ Business ☐ Other
No. Bedrooms 5 No. Persons ____ No. Employees ____


Water Supply: ☐ Individual ☐ Public ☐ Community

☐ Slab ☐ Crawl Space ☐ Basement w/plumbing ☐ Basement wo/plumbing


Comments:/Conditions: Must hug Property line with driveway. Fill house against foundation

Comments:/Conditions: Keep any Future pool at least 15ft From Septic System
Drill 3/16" hole ~54 panels Total
Use "In line" filter in PT 9/11/06 Checked-Hanks

INITIAL SITE SKETCH

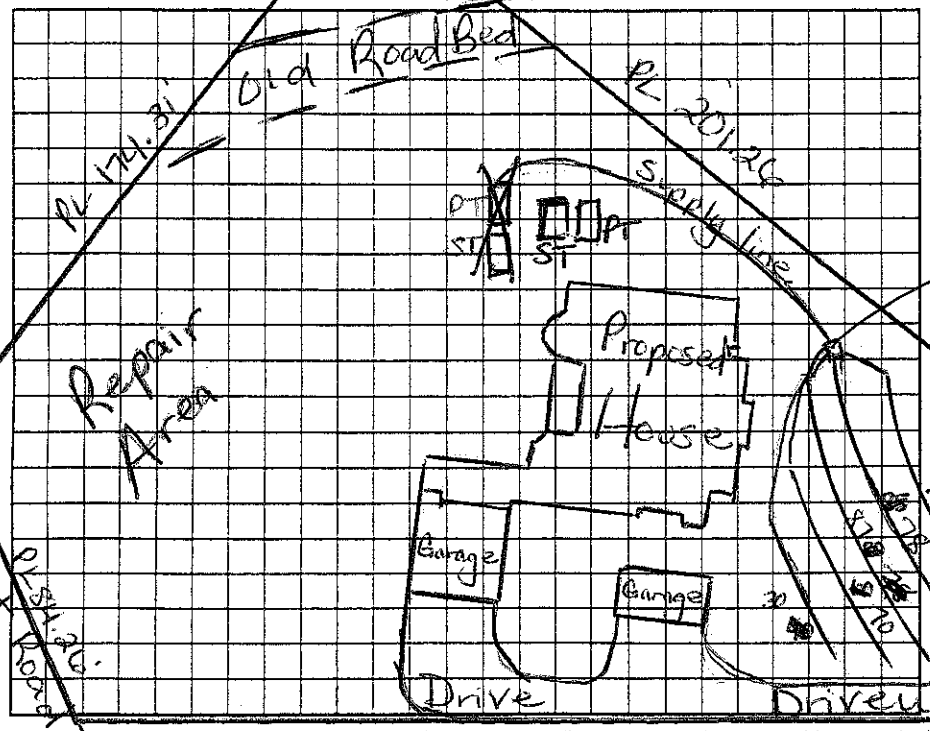

AS BUILT SKETCH

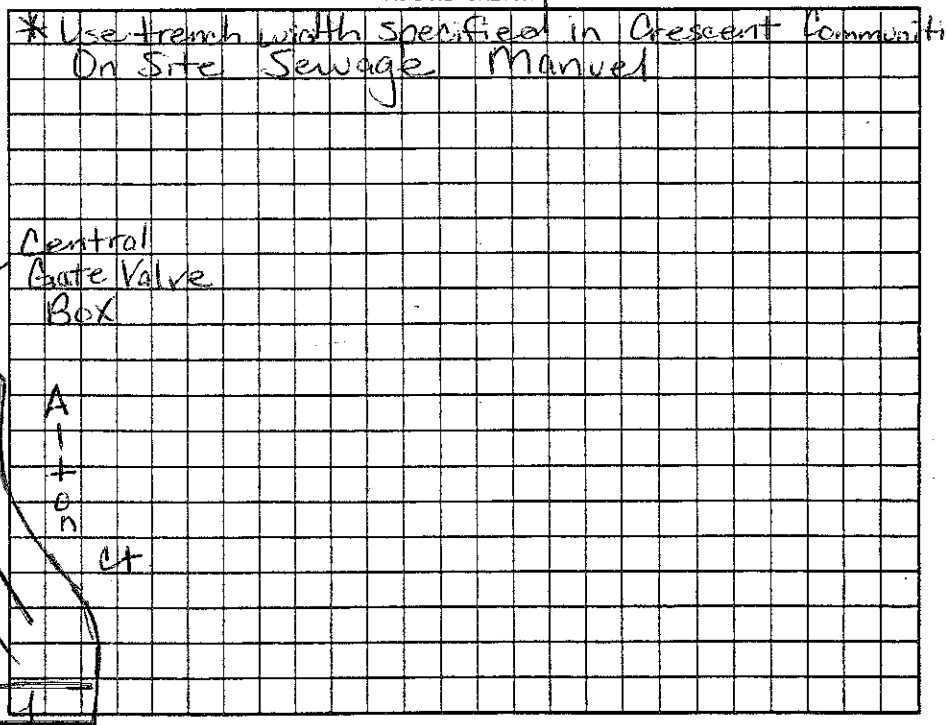

Permit can be suspended or revoked if any false information is supplied toward securing the permit/any unauthorized changes are made to the site/any unauthorized changes are made in the installation of the system. Improvement Permit with plat valid without expiration ☐ Improvement Permit with site plan valid for sixty months ☐ Authorization to Construct is valid for a period equal to that of Improvement Permit – not to exceed sixty months.

Signed: Molly Heaton date 4-7-06
Improvement Permit by: Mana H/L Dotson RS date 3/21/06
Authorization to Construct by: Mana H/L Dotson RS date 3/21/06

Installed by: ____ date ____
Operation Permit by: Mana H/L Dotson RS date 10/25/06
Existing System Inspection by: ____ date ____

HEALTH DEPT. COPY: WHITE OWNER COPY (FINAL): YELLOW OWNER COPY (INITIAL): PINK