IREDELL COUNTY HEALTH DEPARTMENT

STATESVILLE 704-878-5305 100.00 Paid MOORESVILLE 704-664-5281

IMPROVEMENT PERMIT / AUTHORIZATION TO CONSTRUCT / OPERATION PERMIT / EXISTING SYSTEM INSPECTION

PERMIT# 119893 PIN# 4625 88 4937.1310 4625-81-4425 DATE 1/11/06

OWNER OR APPLICANT Kenneth Beeler Homes PHONE: Business 704-746-4669 Home

ADDRESS PO Box 3398 Mooresville NC. 28117

LOCATION 1100 L Yacht Rd. L on Milford Circle 1st lot on (R)

SUBDIVISION POINT BLOCK / SECTION 13 LOT 1310 LOT AREA 53424 FT² SITE CLASS. PS DESIGN FLOW 480 L.T.A.R. .25-3

Septic Tank: 1500 Gallons; STB Date

Pump Tank: 1000 Gallons; PT Date

Pump Make: Model Serial No.

Nitrification Field: No Fields 1 Square Feet 640 Linear Feet 320

No Lines 4@80' Trench Width 2' Max Trench Bottom Depth 3' Gravel Depth NA

☒ New System ☐ Repair ☐ Expansion System Type: I II III (IV) V VI

System Description: LOW PRESSURE - PABS

Repair System Description: SAME

Maintenance Agreement Required: ☒ Yes ☐ No

☒ House/Mod. Home ☐ Mobile Home ☐ Business ☐ Other

No. Bedrooms 4 No. Persons 4 No. Employees


Water Supply: ☐ Individual ☐ Public ☒ Community POINT

☐ Gravity ☐ Pressure ☐ Slab ☐ Crawl Space ☒ Basement w/plumbing ☐ Basement wo/plumbing

Comments:/Conditions: Skipped 1 line in Initial Drainfield area due to big tree; Can be used for Repair


Comments:/Conditions: Tanks Checked 9/20/05 MD
Lines Checked 11/19/06 MD
Pressure, elect & alarm 1/23/06 MD

INITIAL SITE SKETCH

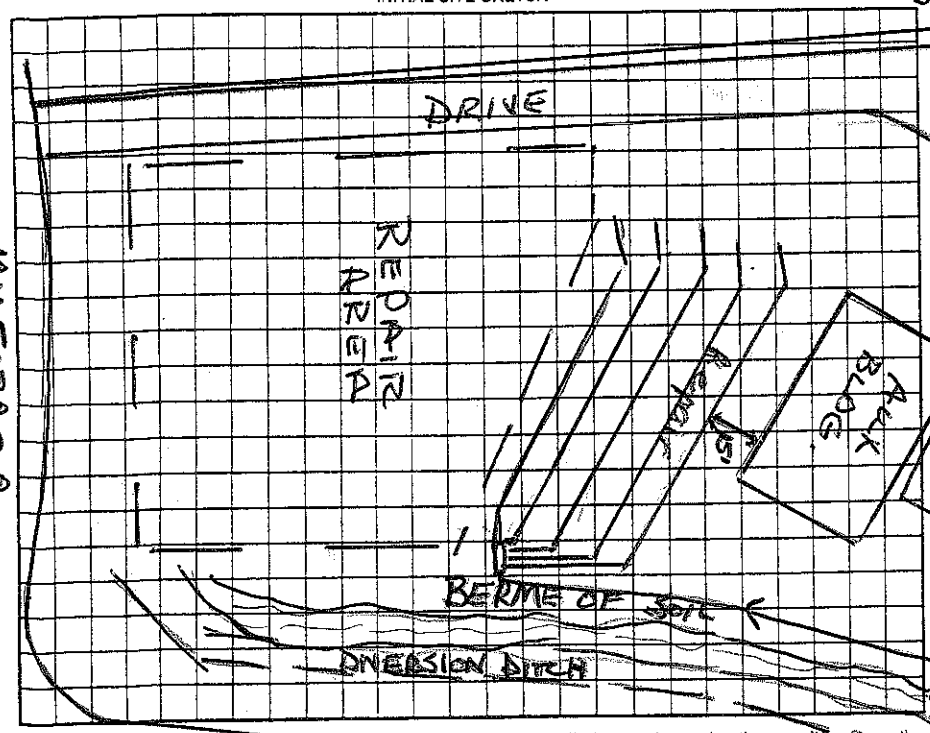

360'

AS BUILT SKETCH

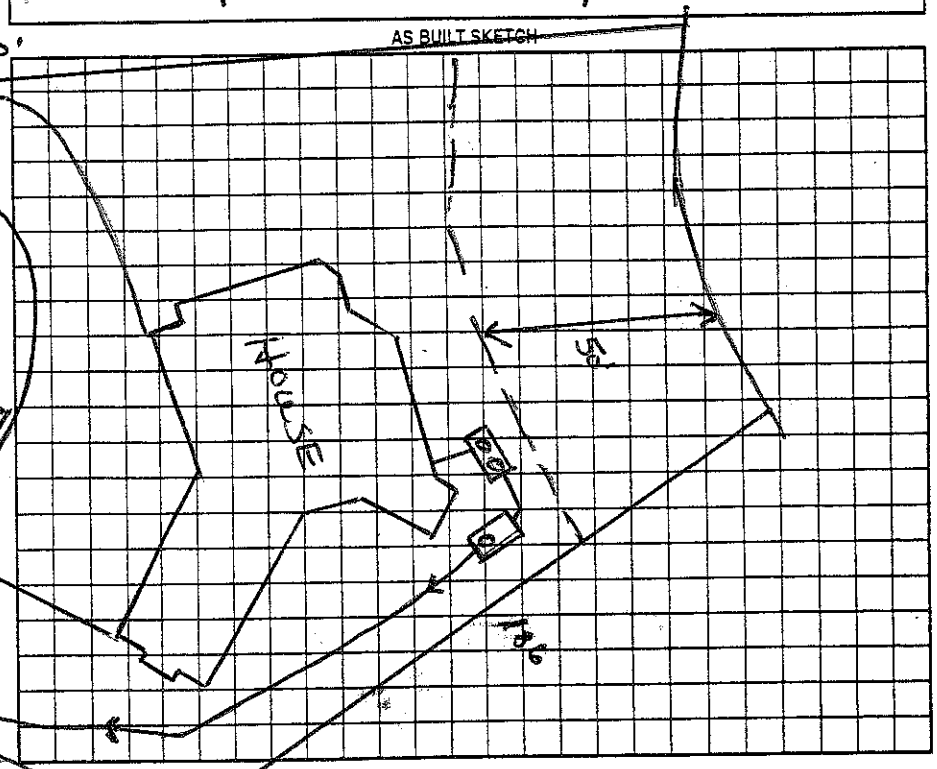

MILFORD CIR.

YACHT RD.

Permit can be suspended or revoked if any false information is supplied toward securing the permit/any unauthorized changes are made to the site/any unauthorized changes are made in the installation of the system. Improvement Permit with plat valid without expiration ☐ Improvement Permit with site plan valid for sixty months ☐ Authorization to Construct is valid for a period equal to that of Improvement Permit – not to exceed sixty months.

Signed: Dan Thomas date 1/11/06

Improvement Permit by: Wesley Sparks RS. date 1/11/06

Authorization to Construct by: Wesley Sparks RS. date 1/11/06

Installed by: R&T Dobson RS date 1/23/06

Operation Permit by: Marvin Dobson date

Existing System Inspection by: date

HEALTH DEPT. COPY: WHITE OWNER COPY (FINAL): YELLOW OWNER COPY (INITIAL): PINK