IREDELL COUNTY HEALTH DEPARTMENT

STATESVILLE 704-878-5305 MOORESVILLE 704-664-5281

IMPROVEMENT PERMIT / CERTIFICATE OF COMPLETION / OPERATION PERMIT / EXISTING SYSTEM INSPECTION

PROPERTY DESCRIPTION NO. 6857 DATE Sept 7, '93 4625815051 TAX MAP NO. 2C2A29

OWNER OR CONTRACTOR Mike Tate / New Trend Homes PHONE: Business _____ Home _____

ADDRESS _____

LOCATION 1100 Tr 1101 ~¼ mile on left

SUBDIVISION Yacht Cove BLOCK / SECTION _____ LOT 29 LOT AREA 1.719 Ac SITE CLASS IS per 1956 L.T.A.R. .3 gal/ft²/day

Water Supply: ☑ Individual ☐ Community ☐ Public J&S Lancaster SC

Septic Tank: 1000 Gallons; STB P+T Date 1-7-94

Pump Tank: 1000 Gallons; PT P+T Date 11-10-93

Nitrification Field: No Fields 1 Square Feet 1200 Linear Feet 400

No Lines 4 Trench Width 36" Trench Depth 24-30" Gravel Depth 12"

☑ New System ☐ Repair System Type: I, II, III, IV, V, VI

System Description: pumped conventional

Repair System Description: LPPPBPS

Maintenance Agreement Required: ☐ Yes ☒ No

☑ House/Mod. Home No. Bedrooms 3

☐ Mobile Home No. Bathrooms 2½

☐ Business No. Employees _____

☐ Other _____

Garbage Disposal: ☑ Yes ☐ No

Auto. Dishwasher: ☑ Yes ☐ No


Auto. Washing Machine: ☑ Yes ☐ No

Other _____

☐ Slab ☑ Crawl Space ☐ Basement w/plumbing ☐ Basement wo/plumbing

Comments Gould WE30H1 M SN2725299

INITIAL SITE SKETCH

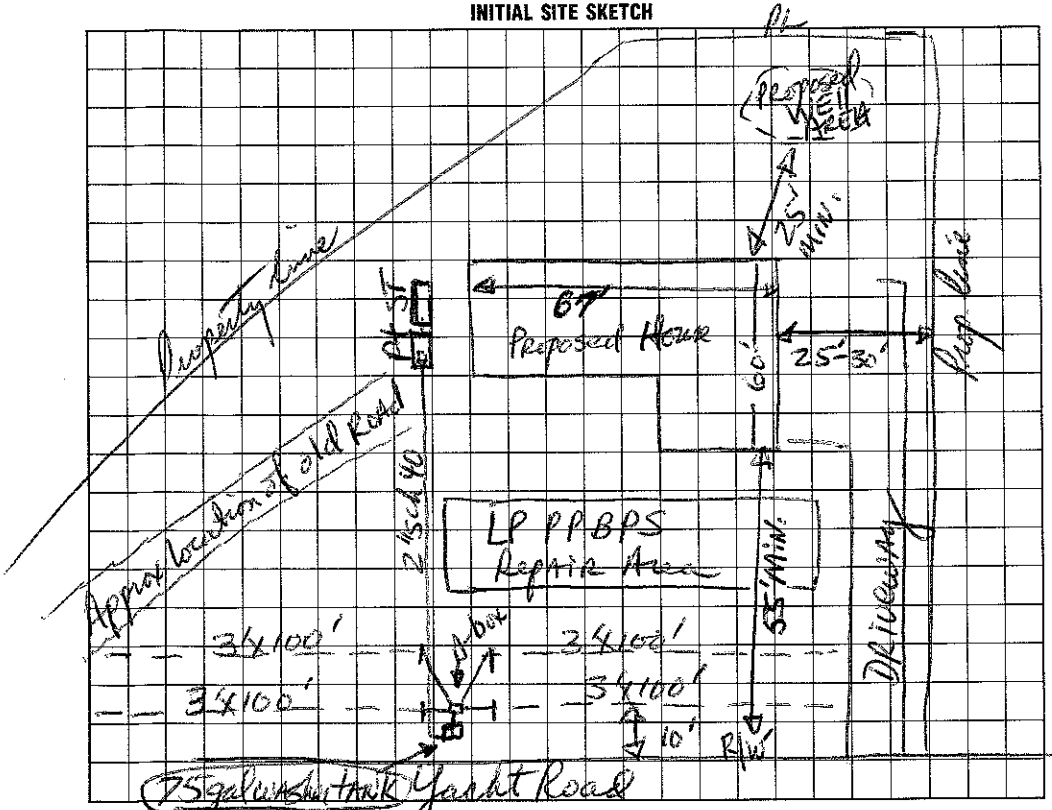

AS BUILT SKETCH

Substantially as shown on initial sketch. Tanks owned perpendicular to side of house.

I understand that this permit can be suspended or revoked if any false information is supplied toward securing the permit/any unauthorized changes are made to the site/any unauthorized changes are made in the installation of the system. Improvement Permit is valid for 60 months from date of issuance.

Signed: [signature] 11/12/93

Improvement Permit by: [signature] RS date 9/7/93

Existing System Inspection by: _____ date _____

Installed by: WT Norwood, Waxhaw

Certificate of Completion by: _____ date _____

Operation Permit by: [signature] RS date 4/26/94

HEALTH DEPT. COPY: WHITE INSPECTION COPY (FINAL): GREEN OWNER COPY (FINAL): YELLOW INSPECTION COPY (INITIAL): PINK OWNER COPY (INITIAL): GOLD