IREDELL COUNTY HEALTH DEPARTMENT

STATESVILLE 704-878-5305 MOORESVILLE 704-664-5281

IMPROVEMENT PERMIT / AUTHORIZATION TO CONSTRUCT / OPERATION PERMIT / EXISTING SYSTEM INSPECTION

PERMIT # 155798 PIN # 4625817585 DATE 4-13-2009

OWNER or APPLICANT Kenneth Bealer Homes PHONE: Business 704 662-6400 Home: 704 663-6899

OWNER or APPLICANT ADDRESS P.O. Box 3398 Mooresville NC 28117

LOCATION / DIRECTIONS (277 Milford Circle) Brawley School Rd TL Yacht Rd TL Milford Circle TR Milford Cir on right

SUBDIVISION The Point BLOCK / SECTION 13 LOT # 1317 LOT AREA DESIGN FLOW 480 gpd L.T.A.R. .3

Septic Tank 1500 Gallons: STB Date

Pump Tank 1000 Gallons: P T Exist Date

Pump Make Model Serial #

Nitrification Field No Fields 1 No Lines 3 Linear Feet 270

Exist Trench Width 36" Max. Trench Bottom Depth 36" Gravel Depth N/A ☐ GRAVITY ☐ PRESSURE

☐ New System ☐ Repair ☐ Expansion System Type I II III IV V VI

System Description: Exist LPPPBPS

Repair System Description: LPPPBPS

Maintenance Agreement Required ☒ YES ☐ NO

☒ Residence No. Bedrooms 4

☐ Business No. Persons

☐ Other No. Employees

☐ Slab ☐ Crawl Space


☐ Basement w/plumbing ☐ Basement w/o plumbing

Water Supply: ☐ Private ☐ Public ☐ Community


Comments / Conditions: Okay to do proposed addition. Should not impact existing tanks & drainfield. However if sewage supply line is encountered must be moved.

Comments / Conditions: If supply line is moved must be by "approved" contractor. Original Septic installed 3/23/04

INITIAL SITE SKETCH

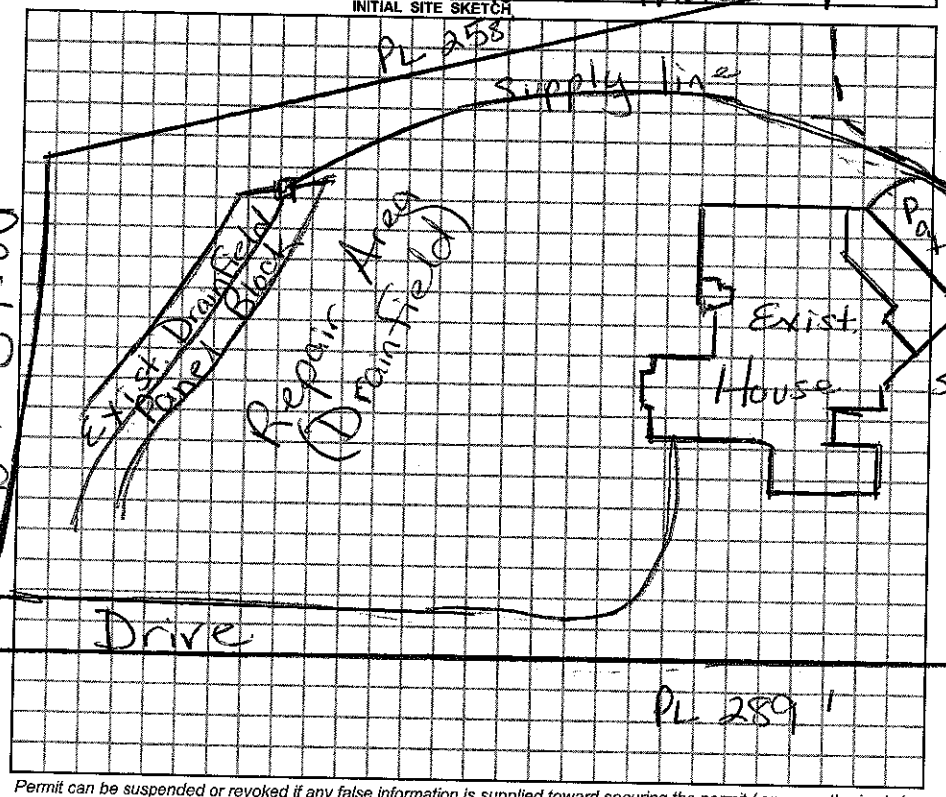

AS BUILT SKETCH

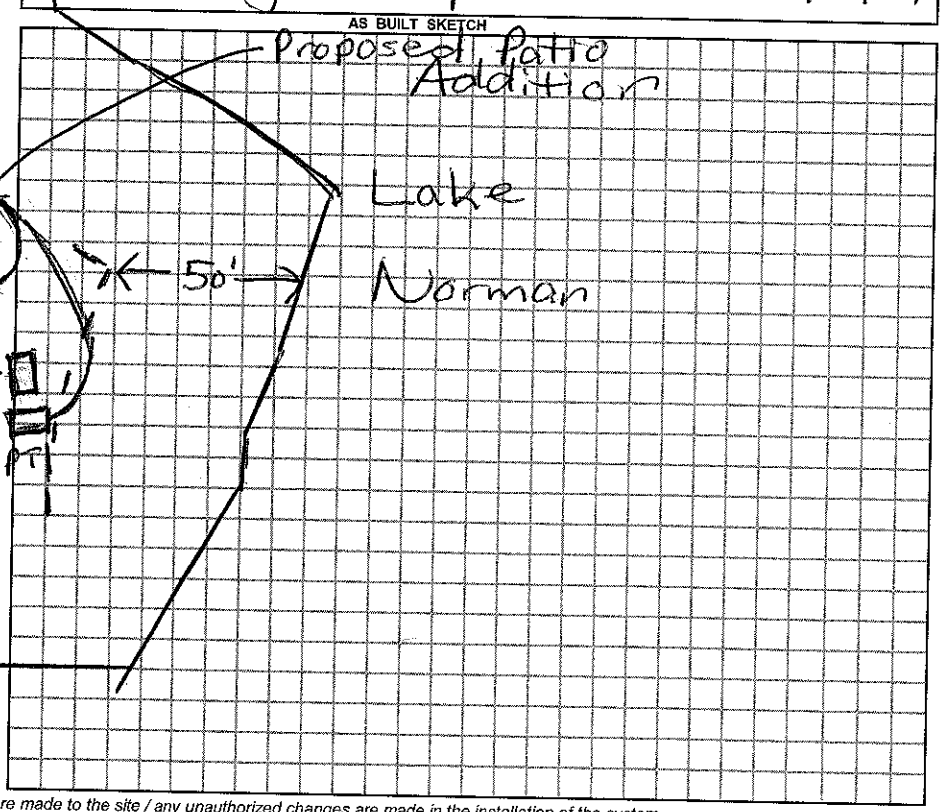

Permit can be suspended or revoked if any false information is supplied toward securing the permit / any unauthorized changes are made to the site / any unauthorized changes are made in the installation of the system.

☐ IMPROVEMENT PERMIT w / plat valid without expiration. ☒ IMPROVEMENT PERMIT w / site plan valid for 60 mos. ☐ AUTHORIZATION TO CONSTRUCT valid for period equal to IMPROVEMENT PERMIT-not to exceed 60 mo.

Owner / Applicant Signature: Kim Bealer Date 4/13/09

Improvement Permit by: Marina H. Nolan Date 4/13/09

Authorzation to Construct by: Marina H. Nolan Date 4/13/09

YOU SHOULD CONTACT A LOCATOR SERVICE PRIOR TO ANY EXCAVATION.

...talled by:

Operation Permit by: Date:

Existing System Inspected by: Marina H. Nolan Date: 4/13/09

WHITE COPY Environmental Health YELLOW COPY (Final) Owner / Applicant PINK COPY (Initial) Owner / Applicant