IREDELL COUNTY HEALTH DEPARTMENT

STATESVILLE 704-878-5305 MOORESVILLE 704-664-5281

IMPROVEMENT PERMIT / AUTHORIZATION TO CONSTRUCT / OPERATION PERMIT / EXISTING SYSTEM INSPECTION

375

PERMIT# 11E926 PIN# 4625-83-4457 4625-81-7585

OWNER OR CONTRACTOR CRI / The Point on Lamar / Kingswood Homes PHONE: Business Home

ADDRESS 2214 Brawley School Rd, Mooresville, NC 28117 DATE April 23 04

LOCATION Brawley School Rd. Rt. Left Road FL Mitford Circle TR Mitford Circle on Right

SUBDIVISION The Point BLOCK / SECTION 1 LOT 1317 LOT AREA 44E15.11 SITE CLASS 1S DESIGN FLOW 4 Bdrm L.T.A.R. .03

Septic Tank: 1500 F Gallons; STB 338 Date 11/22/04

Pump Tank: 1000 Gallons; PT 283 Date 12/27/05

Pump Make: Gorman Model WEO 712 HH Serial No. E0563973

Nitrification Field: No Fields 1 Square Feet 540/910 Linear Feet 370

No Lines 3 Trench Width 24" min 36" Max Trench Bottom Depth 36"

☑ New System ☐ Repair System Type: I. II. III. IV. V. VI

System Description: LPP65

Repair System Description: LPP65

Maintenance Agreement Required: ☑ Yes ☐ No

☐ House/Mod. Home No. Bedrooms 4

☐ Mobile Home No. Bathrooms 4

☐ Business No. Employees

☑ Other

☐ Slab ☐ Crawl Space ☑ Basement w/plumbing ☐ Basement wo/plumbing


Water Supply: ☐ Individual ☑ Public ☑ Community

Comments:/Conditions: @ 36" MIN 4'oc


Comments:/Conditions:

1"=50'

INITIAL SITE SKETCH

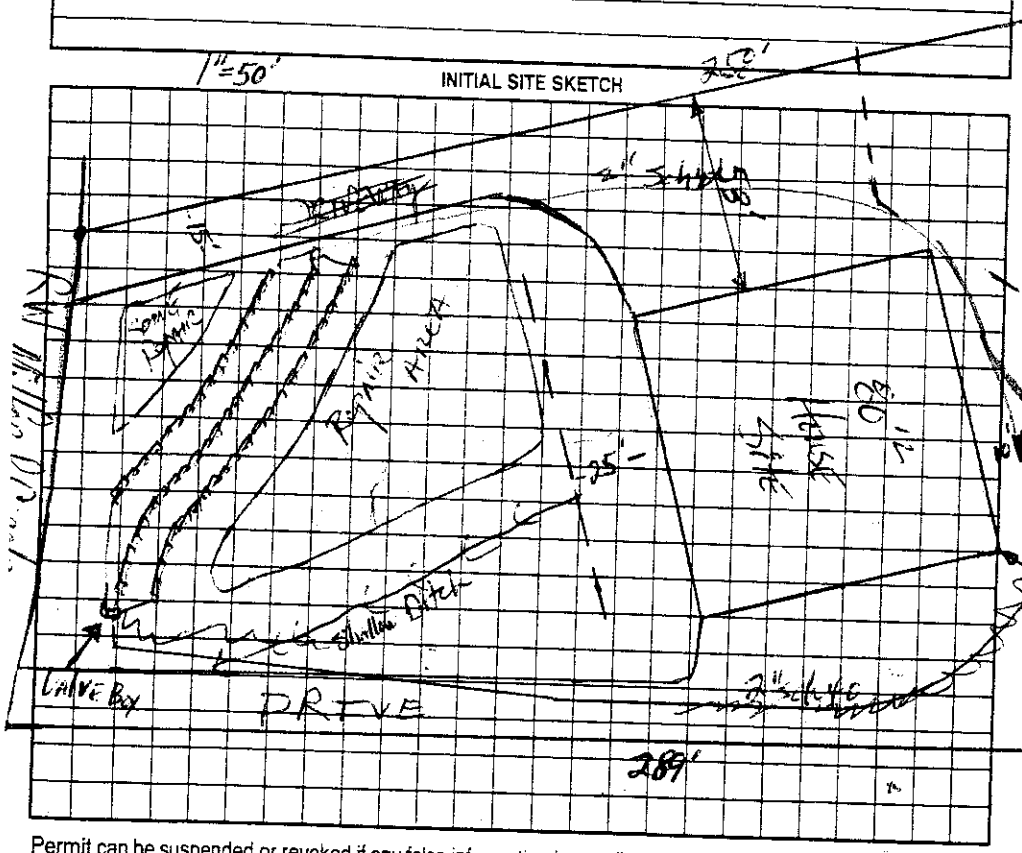

AS BUILT SKETCH

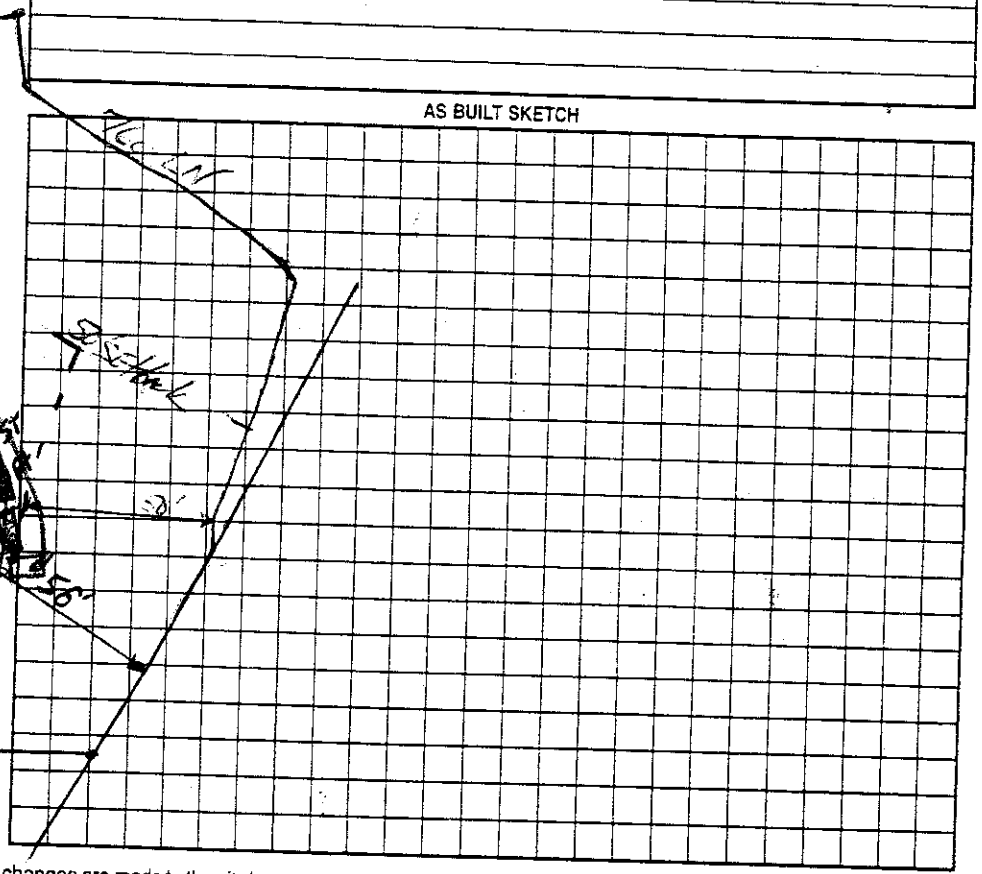

Permit can be suspended or revoked if any false information is supplied toward securing the permit/any unauthorized changes are made to the site/any unauthorized changes are made in the installation of the system. Improvement Permit with plat valid without expiration. Improvement Permit with site plan valid for sixty months. Authorization to Construct is valid for a period equal to that of Improvement Permit – not to exceed sixty months.

Signed: date 6-28-04

Improvement Permit by: date 4-23-04

Authorization to Construct by: Wesley Sparks RS. date 8/11/05

Installed by: Hallman Const. Co.

Operation Permit by: Wesley Sparks RS. date 3/23/06

Existing System Inspection by: date

HEALTH DEPT. COPY: WHITE OWNER COPY (FINAL): YELLOW OWNER COPY (INITIAL): PINK