IREDELL COUNTY HEALTH DEPARTMENT

STATESVILLE 704-878-5305 50.00 Paid MOORESVILLE 704-664-5281 3.00

IMPROVEMENT PERMIT / AUTHORIZATION TO CONSTRUCT / OPERATION PERMIT / EXISTING SYSTEM INSPECTION

PERMIT# 11891 PIN# 4625834957.1316 4625-81-7771 DATE 7-20-05

OWNER OR CONTRACTOR Poore Builders PHONE: Business Home

ADDRESS 10590 Independence Pointe Parkway Ste 100 Matthews NC 28105

LOCATION Brawley School Rd TL Yacht Rd TL Milford Circle TR Milford Circle 3rd on Rt

SUBDIVISION The Point BLOCK / SECTION LOT 131 LOT AREA 37552 SITE CLASS. PS DESIGN FLOW 480 gpd L.T.A.R. .25

Septic Tank: 1500+ Gallons; STB 338 Date 7-3-05

Pump Tank: 1500 Gallons; PT 27 Date 7-3-05

Pump Make: Env96 Model WEO-312 Serial No.

Nitrification Field: No Fields 1 Square Feet 960 Linear Feet 320

No Lines 4 Trench Width 24" -36" Max Trench Bottom Depth 36" Gravel Depth N/A

X New System ☐ Repair System Type: I, II, III, IV, V, VI

System Description: Pump-Panel Blk

Repair System Description: Same

Maintenance Agreement Required: X Yes ☐ No

X House/Mod. Home ☐ Mobile Home ☐ Business ☐ Other

No. Bedrooms 4 No. Bathrooms 4.5 No. Employees

☐ Slab X Crawl Space X Basement w/plumbing ☐ Basement wo/plumbing

Water Supply: ☐ Individual X Public X Community


Comments/Conditions: Checked 2 of 4 lines 8/12/05 & tanks

Checked other 2 lines 8/15/05 MD


Comments/Conditions: X This permit replaces permit dated 4-23-04; due to change in driveway.

9/8 Trench moved above top line (40')

Scale 1:50 INITIAL SITE SKETCH

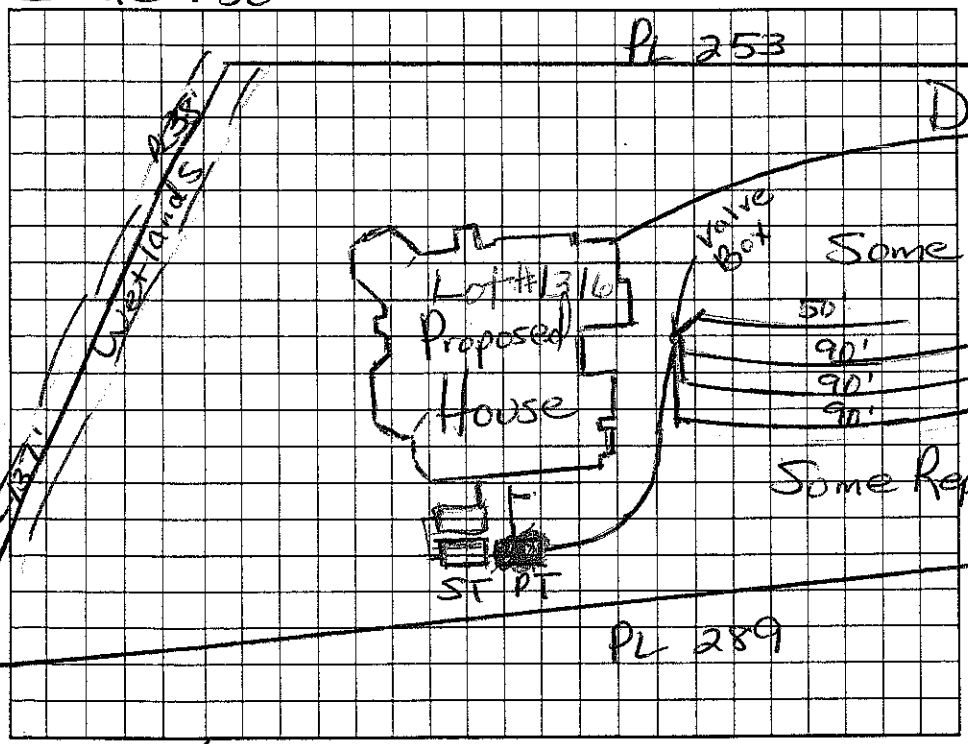

AS BUILT SKETCH

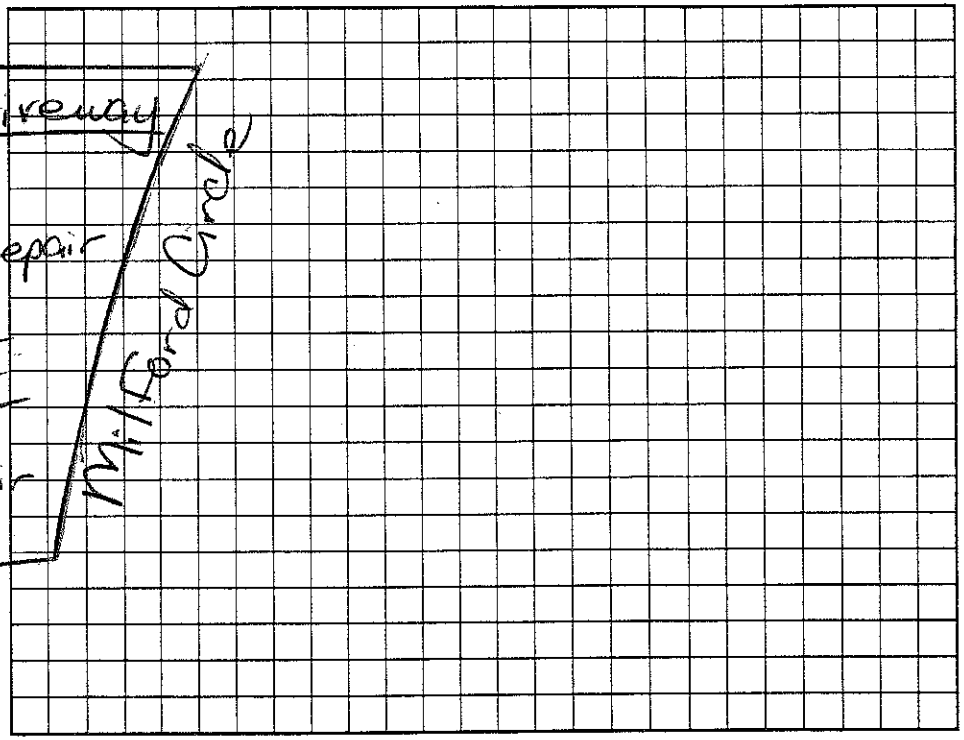

Permit can be suspended or revoked if any false information is supplied toward securing the permit/any unauthorized changes are made to the site/any unauthorized changes are made in the installation of the system. Improvement Permit with plat valid without expiration. Improvement Permit with site plan valid for sixty months. Authorization to Construct is valid for a period equal to that of Improvement Permit – not to exceed sixty months.

Signed: date 7/22/05 Installed by: R&F

Improvement Permit by: Maria Dolan RS date 7/20/05 Operation Permit by: Wesley Sparks RS. date 9/8/05

Authorization to Construct by: Maria Dolan RS date 7/20/05 Existing System Inspection by: date

HEALTH DEPT. COPY: WHITE OWNER COPY (FINAL): YELLOW OWNER COPY (INITIAL): PINK