IREDELL COUNTY HEALTH DEPARTMENT

STATESVILLE 704-878-5305 MOORESVILLE 704-664-5281

IMPROVEMENT PERMIT / AUTHORIZATION TO CONSTRUCT / OPERATION PERMIT / EXISTING SYSTEM INSPECTION

PERMIT# 116925 PIN# 4625-83-4957, 1318 4625-81-9405 DATE May 13, 04

OWNER OR CONTRACTOR Crescent Resources dba/ The Point Norman/Kingswood PHONE: Business _____ Home _____

ADDRESS 2214 Brawley School Rd, Mooresville, N.C. 28117

LOCATION S & E Brawley School Rd TL Yacht Rd TL Milford Circle TR on Milford Circle on Right

SUBDIVISION The Point BLOCK / SECTION 13 LOT 1316 LOT AREA 31,246ft² + 15,308ft² SITE CLASS: PS, SSPE DESIGN FLOW 480gpd L.T.A.R. .3 onsite; .3 SFE

Septic Tank: ~~400~~ 1500 Gallons; STB 336 Date _____

Pump Tank: 1000 Gallons; PT 27 Date _____

Pump Make: Goulds Model WE0512HH Serial No. E1060847

Nitrification Field: No. Fields _____ Square Feet 540/810 Linear Feet 270

No Lines ~~4~~ 3 Trench Width 24" min 36" max Max Trench Bottom Depth 36" Gravel Depth NA

☐ New System ☐ Repair System Type: I, II, III, IV, V, VI

System Description: LPPPBPS on site

Repair System Description: LPPPBPS - some on site

Maintenance Agreement Required: ☑ Yes ☐ No 100% off site SFE

☑ House/Mod. Home No. Bedrooms 4

☐ Mobile Home No. Bathrooms 4

☐ Business No. Employees _____

☐ Other _____

☐ Slab ☑ Crawl Space ☑ Basement w/plumbing ☐ Basement wo/plumbing


Water Supply: ☐ Individual ☑ Public ☑ Community

Comments:/Conditions: 6R36" min 910L

Comments:/Conditions: (original) 3 lines 90' long installed / VB on ② of yard facing house

Irrigation system being installed just above upper drain line.

INITIAL SITE SKETCH

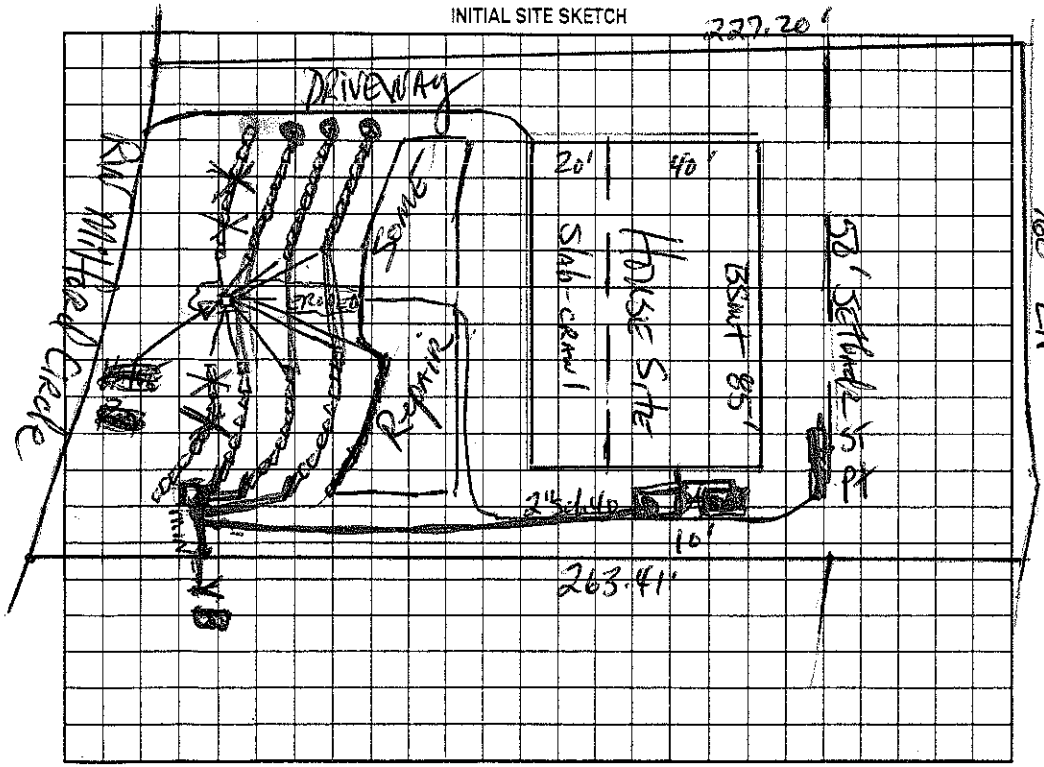

AS BUILT SKETCH

Maintenance by Tri County Water.

Permit can be suspended or revoked if any false information is supplied toward securing the permit/any unauthorized changes are made to the site/any unauthorized changes are made in the installation of the system. Improvement Permit with plat valid without expiration. Improvement Permit with site plan valid for sixty months. Authorization to Construct is valid for a period equal to that of Improvement Permit – not to exceed sixty months.

Signed: _____ date 6-22-04 Installed by: Hallman Construction

Improvement Permit by: _____ date 5-13-04 Operation Permit by: Wesley Sparks RS. date 6/22/06

Authorization to Construct by: _____ RS date 9/23/05 Existing System Inspection by: _____ date _____

HEALTH DEPT. COPY: WHITE OWNER COPY (FINAL): YELLOW OWNER COPY (INITIAL): PINK