IREDELL COUNTY HEALTH DEPARTMENT

STATESVILLE 704-878-5305 MOORESVILLE 704-664-5281

550.00 Paid 3100

IMPROVEMENT PERMIT / AUTHORIZATION TO CONSTRUCT / OPERATION PERMIT / EXISTING SYSTEM INSPECTION

PERMIT# 130342 PIN# 4625 82 3567. 1379 DATE 5/4/06

OWNER OR APPLICANT Tom Stevenson PHONE: Business 704 660 6638 Home

ADDRESS 570 Williamson Rd. Mooresville NC 28117

LOCATION 1100 TL Chesterwood Court 2nd lot on (L)

SUBDIVISION Point BLOCK / SECTION 13 LOT 1379 LOT AREA .832 SITE CLASS. PS DESIGN FLOW 480 L.T.A.R. 5.3 #bdms

Septic Tank: 1000 Gallons; STB 338 Date 8-25-06
Pump Tank: 1000 Gallons; PT Date
Pump Make: Model Serial No.
Nitrification Field: No Fields 1 Square Feet 672 Linear Feet 336
No Lines 4 @ 84' Trench Width 2' Max Trench Bottom Depth 3' Gravel Depth No

☒ New System ☐ Repair ☐ Expansion System Type: I II III IV V VI
System Description: LP PPBPS
Repair System Description: SAME
Maintenance Agreement Required: ☒ Yes ☐ No

☒ House/Mod. Home No. Bedrooms 4
☐ Mobile Home No. Persons 4
☐ Business No. Employees
☐ Other

Water Supply: ☐ Individual ☐ Public ☒ Community


☐ Gravity ☒ Pressure ☐ Slab ☐ Crawl Space ☒ Basement w/plumbing ☐ Basement wo/plumbing

Comments:/Conditions:


Comments:/Conditions: Plan submitted – Bonus Room is entirely bedroom – 5 TOTAL 10/31/06 AWS

1" = 50'

INITIAL SITE SKETCH

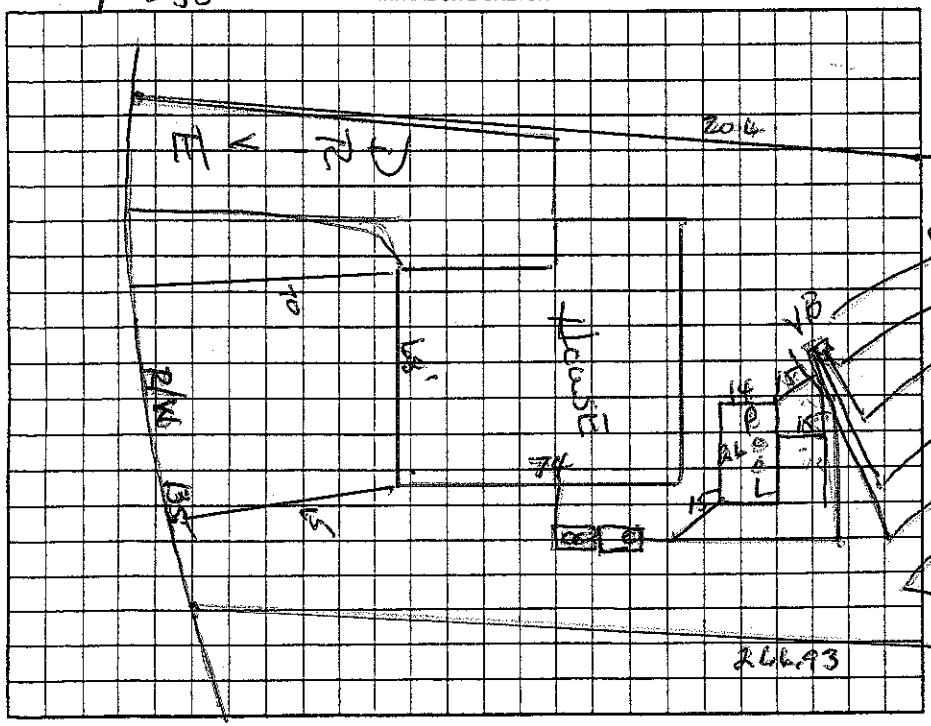

AS BUILT SKETCH

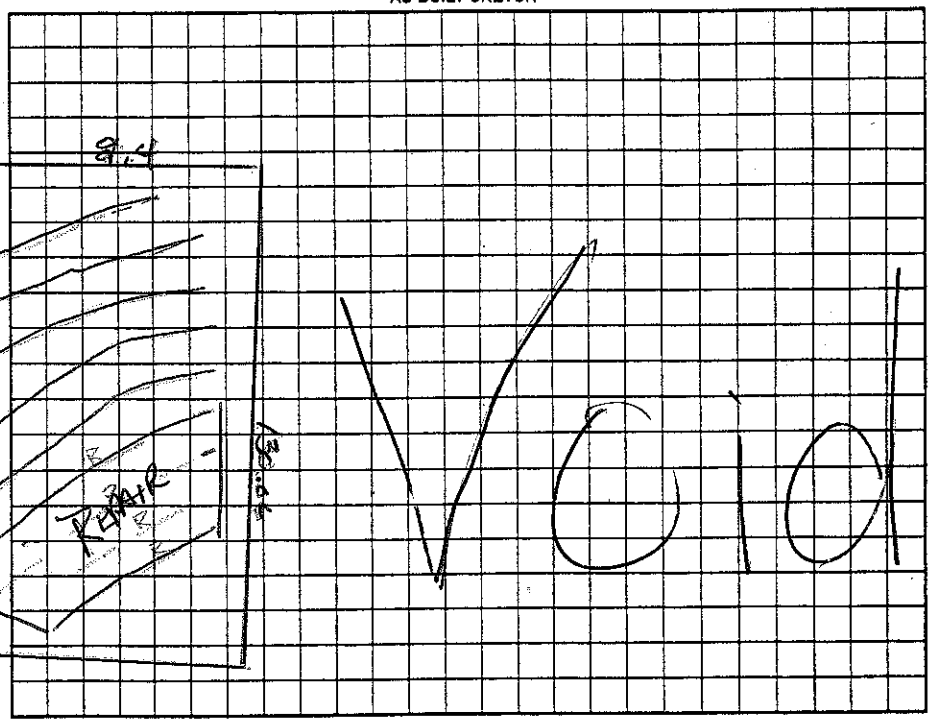

Permit can be suspended or revoked if any false information is supplied toward securing the permit/any unauthorized changes are made to the site/any unauthorized changes are made in the installation of the system. Improvement Permit with plat valid without expiration ☐ Improvement Permit with site plan valid for sixty months ☐ Authorization to Construct is valid for a period equal to that of Improvement Permit – not to exceed sixty months.

Signed: [signature] date 5/15/06 Installed by:

ment Permit by: Wesley Sparks RS date 5/4/06 Operation Permit by: date

ation to Construct by: Wesley Sparks RS date 5/4/06 Existing System Inspection by: date

HEALTH DEPT. COPY: WHITE OWNER COPY (FINAL): YELLOW OWNER COPY (INITIAL): PINK